


STATE OF KANSAS  
STATE CORPORATION COMMISSION

Give All Information Completely  
Make Required Affidavit  
Mail or Deliver Report to:  
Conservation Division  
State Corporation Commission  
800 Bittling Building  
Wichita, Kansas

WELL PLUGGING RECORD

Rush County. Sec. 23 Twp. 18 Rge. 16W (E) (W)

NORTH

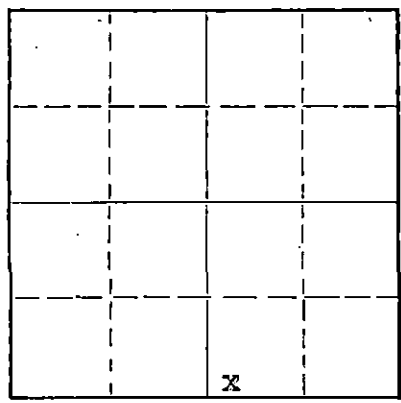

Locate well correctly on above  
Section Plat

Location as "NE/CNW/SW" or footage from lines \_\_\_\_\_  
Lease Owner Dun Mar Oil & Gas Co.  
Lease Name H. R. Woodward Well No. 2  
Office Address Otis, Kans.  
Character of Well (completed as Oil, Gas or Dry Hole) Gas  
Date well completed 5 / 31 / 37 19\_\_\_\_  
Application for plugging filed 8 / 30 / 57 19\_\_\_\_  
Application for plugging approved 8 / 30 / 57 19\_\_\_\_  
Plugging commenced 9/1 1957  
Plugging completed 9/5 1957  
Reason for abandonment of well or producing formation Not paying

If a producing well is abandoned, date of last production \_\_\_\_\_ 19\_\_\_\_  
Was permission obtained from the Conservation Division or its agents before plugging was commenced? Yes

Name of Conservation Agent who supervised plugging of this well Russell Brundage, Hoisington, Kans.  
Producing formation Reagen Sand Depth to top 3530 Bottom 3535 Total Depth of Well 3560 Feet  
Show depth and thickness of all water, oil and gas formations.

OIL, GAS OR WATER RECORDS

CASING RECORD

FORMATION	CONTENT	FROM	TO	SIZE	PUT IN	PULLED OUT
				15 1/2"	210	None
				10"	975	None
				7"	3523	1506

Describe in detail the manner in which the well was plugged, indicating where the mud fluid was placed and the method or methods used in introducing it into the hole. If cement or other plugs were used, state the character of same and depth placed, from \_\_\_\_\_ feet to \_\_\_\_\_ feet for each plug set.

3449 to 3235 ft. Sand  
 3235 to 3200 7 Sks., cement, dumped  
 3200 to 400 Mudded, shoveled in.  
 400 to 375 Rock bridge.  
 375 to 325 25 Sks., cement.  
 325 to 20 Mud, shoveled in  
 20 to Cellar 10 Sks., cement

(If additional description is necessary, use BACK of this sheet)

Name of Plugging Contractor R & S Pipe Pulling Co. Ellinwood, Kans. License # 1  
Address \_\_\_\_\_

STATE OF Kansas, COUNTY OF Barton, ss.  
Olin Koochel (employee of owner) or (owner or operator) of the above-described well, being first duly sworn on oath, says: That I have knowledge of the facts, statements, and matters herein contained and the log of the above-described well as filed and that the same are true and correct. So help me God.

(Signature) Olin Koochel  
Otis, Kansas, (Address)

SUBSCRIBED AND SWORN to before me this 17th day of September, 1957

My commission expires July 20th, 1959.  
L. S. Shneider Notary Public.

PLUGGING  
FILE SEC. 23 T. 18 R. 16W  
BOOK PAGE 41 LINE 11

Dunn-Mar Oil & Gas Co.  
Otis, Kans.

Well log of H. R. Woodward # 2 s/w s/w s/e 23/18/16  
Rush Co. Kans. Elev. 1927 Completed 5 / 31 / 37  
Reagen Sand. Td. 3560 57 Bbls. oil

Formations	Thicknes	Casing	FT.	Cement
Cellar	10	15 $\frac{1}{2}$	202	225 Sks.
Surface clay	60	10	988 968	528
Water sand	80	7	3523	528
Shale shells	130	Depleted in 1953		
Shale sand	216			
Shale	260			
Shells	270			
Shale	350			
Shale lime	390	July 1956		
Water sand	503	Completed as disposal well		
Shale	540	Plugged back with sand to 3474		
Sand	624	three sacks Cal Seal five sacks		
Shale	660	cement. top of plug 3449		
Red bed	670	perforated from 3246 down to		
Shale	735	3348		
Red rock	960			
Anhydrite	995			
Shale	1148			
Shale shells	1312			
Shale lime	1385			
Salt	1400	Called in for plugging permit		
Shale	1550	8/30/57. received Permit 8/31/57		
Shale shells	1655	Plugging commenced 9/1/57		
Shale	1680	Completed 9/5/57		
Lime	1778	State Plugger Mr. Russel Brundage		
Broken lime	1950	Hoisington, Kan.		
Lime shale	2055			
Lime	2108			
Lime shale	2730			
lime	2740			
Shaley lime	2792			
Lime	3320			
Poures soft lime	3320			
Lime	3342			
Grey lime	3390			
Lime	3470			
Brown shale <del>348</del>	3484			
Sandy lime	3485			
Hard sand	3509			
Red rock	3523			
Red rock	3526			
Hard sand	3528			
Sand	3543			
Granit wash	3544			
T. D.	3560			

Dunn-Mar Oil & Gas Co.

*Olin Koochel*

Olin Koochel  
Otis, Kans.

RECEIVED  
STATE CORPORATION COMMISSION

SEP 18 1957

CONSERVATION DIVISION  
Wichita, Kansas

<b>PLUGGING</b>
FILE SEC. <u>23 T 18 R16W</u>
BOOK <u>41</u> LINE <u>11</u>