

STATE OF KANSAS
STATE CORPORATION COMMISSION

Form CP-1

Give All Information Completely
Make Required Affidavit
Mail or Deliver Report to
Conservation Division
State Corporation Commission

P. O. Box 17027
Wichita, Kansas 67217
NORTH

WELL PLUGGING RECORD

Locate well correctly on above
Section Plat

Rush County, Sec. 23 Twp. 18, Rge. 16 (E) (W) X
 Location as "NE/CNW/SE" or footage from lines C S/2 N/2 SE
 Lease Owner Twin Western Resources, Inc.
 Lease Name O. Schroeder Well No. #5
 Office Address Suite 518, 200 East First St. Wichita, Kansas
 Character of Well (completed as Oil, Gas or Dry Hole) _____
 Date well completed _____ 19____
 Application for plugging filed _____ 19____
 Application for plugging approved _____ 19____
 Plugging commenced 3-8-74 _____ 19____
 Plugging completed 3-21-74 _____ 19____
 Reason for abandonment of well or producing formation _____

If a producing well is abandoned, date of last production _____ 19____
 Was permission obtained from the Conservation Division or its agents before plugging was commenced? _____

Name of Conservation Agent who supervised plugging of this well Leo Massey
 Producing formation _____ Depth to top _____ Bottom _____ Total Depth of Well 3570' Feet
 Show depth and thickness of all water, oil and gas formations.

OIL, GAS OR WATER RECORDS

CASING RECORD

FORMATION	CONTENT	FROM	TO	SIZE	PUT IN	PULLED OUT
				5 1/2"	3502'	1335.68'
				8 5/8"	984'	
				12 1/2"	120'	

Describe in detail the manner in which the well was plugged, indicating where the mud fluid was placed and the method or methods used in introducing it into the hole. If cement or other plugs were used, state the character of same and depth placed, from _____ feet to _____ feet for each plug set.

Made bottom hole plug back with sand to 3480'. Mixed and ran 5 sacks cement thru dump trailer.
Mudded hole to 400' - set 15' rock bridge. Filled hole with 5 1/2 hards of ready-mix to base of cellar.


RECEIVED
 STATE CORPORATION COMMISSION
 MAR 25 1974
 CONSERVATION DIVISION
 Wichita, Kansas

(If additional description is necessary, use BACK of this sheet)
 Name of Plugging Contractor Southwest Casing Pulling Co.
 Address Box 364 Great Bend, Kansas

STATE OF Kansas COUNTY OF Barton ss.

Southwest Casing Pulling Co. (employee of owner) or (owner or operator) of the above-described well, being first duly sworn on oath, says: That I have knowledge of the facts, statements, and matters herein contained and the log of the above-described well is filed and that the same are true and correct. So help me God.

(Signature) W. C. Spencer Sec.
Box 364 Great Bend, Kansas
 (Address)

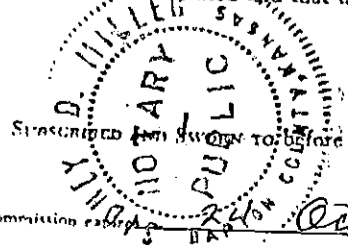


Subscribed and sworn to before me this 22 day of March 1974
Sidney D. Miller
 Notary Public.

WICHITA COUNTY GEOLOGICAL SOCIETY
 412 CHURCH ST. WICHITA, KANSAS

Company FLYNN OIL COMPANY ET AL
 Farm O. Schroeder No. 5

Sec. 23 T. 18 R. 16W
 CS# N# 2E

Total Depth 3570'
 Date 12-29-41
 Shot & Log No. 1-11-48
 Contractor Lylward Drilling Co.
 Date 7-17-40

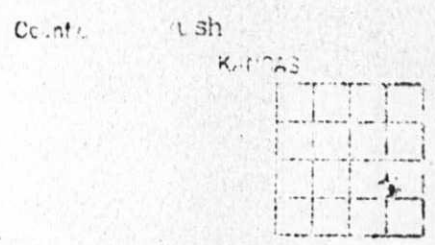

CASING
 12-1/2" 120' Cem. w/115 sx
 8-5/8" 984' Cem. w/300 sx
 5-1/2" 3502' Cem. w/75 sx

Depth
 Section 15 BC

surface soil & clay	0-30
sand & gravel	120
red bed & shale	240
sand	255
red bed & shale blue	350
shale	395
sand	500
shale	545
sand	680
shale & shells	750
red bed & shells	950
red bed	970
anhydrite	995
red bed	1175
shale & shells	1430
salt	565
shale & shells	1765
shale & lime	2065
lime hrd	2115
lime & shale	2135
lime	2255
lime & shale	2355
shale & shells	2505
lime & shale	2755
shale & shells	2825
lime & shale	3015
lime	3095
lime sdy & shale	3165
shale & lime	3235
lime	3400
lime & sand	3420
lime	3507
sand	3568
shale	3570
Total Depth	

RECEIVED
 STATE CORPORATION COMMISSION
 JAN 25 1974
 CONSERVATION DIVISION
 Wichita, Kansas