


STATE OF KANSAS
STATE CORPORATION COMMISSION

Give All Information Completely
Make Required Affidavit
Mail or Deliver Report to:
Conservation Division
State Corporation Commission
P. O. Box 17027
Wichita, Kansas 67217
NORTH

WELL PLUGGING RECORD

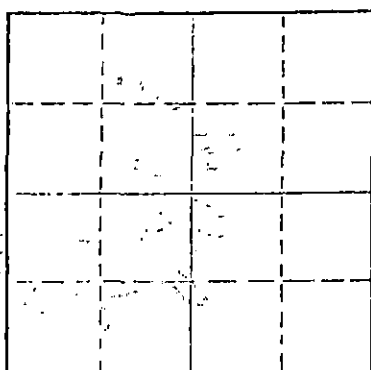

Locate well correctly on above
Section Plot

Rush County. Sec. 23 Twp. 18 Rge. 16 (E) (W) X
Location as "NE/CNW/SE" or footage from lines. NE SE SE
Lease Owner Midway Drilling Inc.
Lease Name J. Schroeder Well No. #2
Office Address Box 921 Great Bend, Kansas
Character of Well (completed as Oil, Gas or Dry Hole) _____
Date well completed _____ 19____
Application for plugging filed _____ 19____
Application for plugging approved _____ 19____
Plugging commenced _____ 19____
Plugging completed 5-10-74 _____ 19____
Reason for abandonment of well or producing formation _____

If a producing well is abandoned, date of last production _____ 19____
Was permission obtained from the Conservation Division or its agents before plugging was commenced? _____

Name of Conservation Agent who supervised plugging of this well Leo Massey
Producing formation _____ Depth to top _____ Bottom _____ Total Depth of Well 3544'
Show depth and thickness of all water, oil and gas formations.

OIL, GAS OR WATER RECORDS

CASING RECORD

FORMATION	CONTENT	FROM	TO	SIZE	PUT IN	PULLED OUT
				5 1/2"	3520'	1300'
				8 5/8"	973'	

Describe in detail the manner in which the well was plugged, indicating where the mud fluid was placed and the method or methods used in introducing it into the hole. If cement or other plugs were used, state the character of same and depth placed, from _____ feet to _____ feet for each plug set.

Set rock bridge from 625' - 600'
Filled hole with 8 yards ready-mix to base of cellar.

RECEIVED
STATE CORPORATION COMMISSION

JUL 21 1974

(If additional description is necessary, use BACK of this sheet)
Name of Plugging Contractor Southwest Casing Pulling Co. CONSERVATION DIVISION
Address Box 364 Great Bend, Kansas (Wichita, Kansas)

STATE OF Kansas COUNTY OF Barton SS.
Southwest Casing Pulling Co. (employee of owner) or (owner or operator) of the above-described well, being first duly sworn on oath, says: That I have knowledge of the facts, statements, and matters herein contained and the log of the above-described well as filed and that the same are true and correct. So help me God.

(Signature) W. C. Spencer, Sec
Box 364 Great Bend, Kansas
(Address)

Sworn to before me this 1 day of July, 19 74

Sidney D. Miller
Notary Public.



WELL LOG BUREAU - KANSAS GEOLOGICAL SOCIETY
412 Union National Bk. Bldg., Wichita, Kansas

COPY


Company - J. A. KYLWARD & FLYNN OIL COMPANY
Farm - J. Schroeder No. 2

SEC. 23 T. 18 R. 16W
NE SE SE
250' SN1 330' NE1 SE1

Total Depth. 3544'
Comm. 6-11-47 Comp. 7-13-47
Shot or Treated. Shot w/20 qts. from 3532-41' (7-9-47)
Contractor. Kylward Drilling Co.
Issued. 8-23-47

County. Rusk

KANSAS

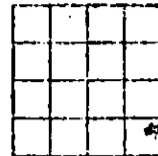

Elevation. _____

Production. Est. 50 BO

CASING:

12-1/2" 126' Com. w/135 sx
8-5/8" 973' Com. w/290 sx
5-1/2" 3520' Com. w/ 50 sx

Figures Indicate Bottom of Formations.

surface clay, sand & gravel	0-70
red bed	128
shale, red	155
clay	175
sand	195
red bed w/ shale blue	230
shale	390
sand	495
shale w/ shells	530
sand	570
shale w/ shells	625
red bed	665
sand	690
red bed	715
shale & shells	735
red bed & shells	815
red rock & shells	840
shale w/ shells	850
red rock w/ shells	920
red bed w/ shells	961
red bed	968
anhydrite	998
red bed	1025
shale w/ shells	1425
salt	1535
shale	1570
shale w/ shells	1675
lime	1720
shale	1870
sand	1910
lime w/ shale	1980
lime	2285
lime & shale	2415
lime brkn	2430
lime & shale	2465
shale	2520
lime & shale	2540
shale	2695
lime w/ shale	2800
shale	2885
lime & shale	2995
lime	3128
lime w/ shale	3210
lime	3495
sand	3544
Total Depth	

RECEIVED
STATE CORPORATION COMMISSION
JAN 25 1974
CONSERVATION DIVISION
Wichita, Kansas