

HIGH HOLE

SIDE ONE

STATE CORPORATION COMMISSION OF KANSAS  
OIL & GAS CONSERVATION DIVISION  
WELL COMPLETION OR RECOMPLETION FORM  
ACO-1 WELL HISTORY  
DESCRIPTION OF WELL AND LEASE

API NO. 15-113-21,216.0000

County McPherson  
150' West of  
NE. SE. SW. Sec. 16. Twp. 21. Rge. 3. XX West

Operator: License # 4569  
Name Jay Boy Oil, Inc  
Address 100 N. Broadway  
Suite 535  
City/State/Zip Wichita, KS. 67202

990 Ft North from Southeast Corner of Section  
3120 Ft West from Southeast Corner of Section  
(Note: Locate well in section plat below)

Purchaser

Lease Name Mildred Ediger Well # 1

Operator Contact Person Gary Sharp  
Phone (316) 264-3700

Field Name Voshell


Producing Formation

Contractor: License # 5418  
Name Allen Drilling Company

Elevation: Ground 1463' KB 1468'

Wellsite Geologist Dave Moutague  
Phone (316) 721-7530

Section Plat

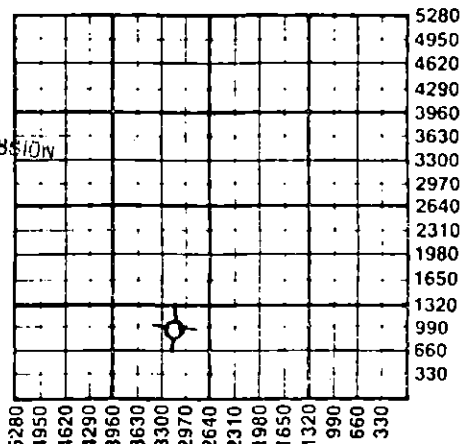

Designate Type of Completion  
X New Well Re-Entry Workover  
Oil SWD Temp Abd  
Gas Inj Delayed Comp.  
X Dry Other (Core, Water Supply etc.)

RECEIVED  
MAR 2 1989  
CONSERVATION DIVISION  
Wichita, Kansas

If OWWO: old well info as follows:  
Operator  
Well Name  
Comp. Date Old Total Depth

WATER SUPPLY INFORMATION

Disposition of Produced Water: Disposal  
Docket # Repressuring

WELL HISTORY  
Drilling Method:  
X Mud Rotary Air Rotary Cable

Questions on this portion of the ACO-1 call:  
Water Resources Board (913) 296-3717  
Source of Water:  
Division of Water Resources Permit # T88-580

11/22/88 11/29/88 11-29-88  
Spud Date Date Reached TD Completion Date  
3530'  
Total Depth PBTD

XX Groundwater Ft North from Southeast Corner  
(Well) Ft West from Southeast Corner of  
Sec Twp Rge East West  
Surface Water Ft North from Southeast Corner  
(Stream, pond etc) Ft West from Southeast Corner  
Sec Twp Rge East West  
Other (explain)  
(purchased from city, R.W.D. #)

Amount of Surface Pipe Set and Cemented at 262' feet  
Multiple Stage Cementing Collar Used? Yes X No  
If yes, show depth set feet  
If alternate 2 completion, cement circulated  
from feet depth to w/ SX cmt  
Cement Company Name  
Invoice #

ATI DYO

INSTRUCTIONS: This form shall be completed in triplicate and filed with the Kansas Corporation Commission, 200. Colorado Derby Building, Wichita, Kansas 67202, within 120 days of the spud date of any well. Rule 82-3-130, 82-3-107 and 82-3-106 apply. Information on side two of this form will be held confidential for a period of 12 months if requested in writing and submitted with the form. See rule 82-3-107 for confidentiality in excess of 12 months. One copy of all wireline logs and drillers time log shall be attached with this form. Submit CP-4 form with all plugged wells. Submit CP-111 form with all temporarily abandoned wells.

All requirements of the statutes, rules and regulations promulgated to regulate the oil and gas industry have been fully complied with and the statements herein are complete and correct to the best of my knowledge.

Signature [Signature]

Title Operations Secretary Date 03/16/89

Subscribed and sworn to before me this 3rd day of March 1989

Notary Public Betty B. Herring

Date Commission Expires 10-27-89

BETTY B. HERRING  
NOTARY PUBLIC  
STATE OF KANSAS  
My Appt. Exp. 10-27-89

K.C.C. OFFICE USE ONLY  
Letter of Confidentiality Attached  
Wireline Log Received  
Drillers Time Log Received  
Distribution  
KCC SWD/Rep NGPA  
KGS Plug Other  
(Specify)  
3-21-89 X (2)  
Form ACO-1 (5-86)

Section 16 Twp 21 Rge 3