

SIDE ONE

TIGHT HOLE!

STATE CORPORATION COMMISSION OF KANSAS  
OIL & GAS CONSERVATION DIVISION  
WELL COMPLETION OR RECOMPLETION FORM  
ACO-1 WELL HISTORY  
DESCRIPTION OF WELL AND LEASE

API NO. 15-113-21-204-0000  
County McPherson  
SW SW Sec 15 Twp 21 Rge 3 East West

Operator License # 4569  
Name Day Boy Oil, Inc  
Address 100 N. Broadway  
Sutie 535  
City/State/Zip Wichita, KS 67202

990 Ft North from Southeast Corner of Section  
4950 Ft West from Southeast Corner of Section  
(Note: Locate well in section plat below)

Purchaser Koch  
Wichita, KS

Lease Name Howard Kaufman Well #4

Operator Contact Person Gary Sharp  
Phone (316) 264-3700

Field Name Pool Extension Voshell

Producing Formation Mississippian

Contractor License # 5418  
Name Allen Drilling Company


Elevation: Ground 1449 KB 1455

Wellsite Geologist Steve Davis  
Phone (316) 267-9115

Designate Type of Completion  
X New Well Re-Entry Workover

X Oil SWD Temp Abd  
Gas Inj Delayed Comp  
Dry Other (Core, Water Supply etc.)

If OWWO: old well info as follows:  
Operator  
Well Name  
Comp. Date Old Total Depth

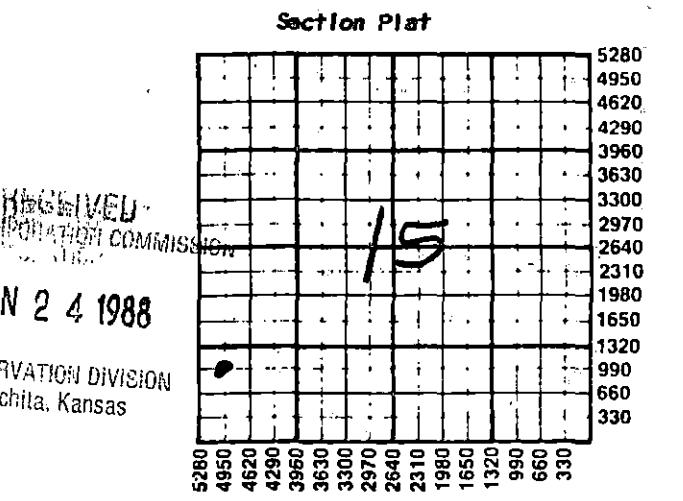

WATER SUPPLY INFORMATION  
Disposition of Produced Water: Disposal  
Docket # Repressuring

Questions on this portion of the ACO-1 call:  
Water Resources Board (913) 296-3717  
Source of Water:  
Division of Water Resources Permit #  
Groundwater Ft North from Southeast Corner (Well) Ft West from Southeast Corner of Sec Twp Rge East West  
Surface Water Ft North from Southeast Corner (Stream, pond etc) Ft West from Southeast Corner Sec Twp Rge East West  
Other (explain)  
(purchased from city, R.W.D. #)

WELL HISTORY

Drilling Method:  
X Mud Rotary Air Rotary Cable  
02/25/88 03/01/88 3/19/88  
Spud Date Date Reached TD Completion Date  
3090'  
Total Depth PBDT  
Amount of Surface Pipe Set and Cemented at 210' @ 217' feet  
Multiple Stage Cementing Collar Used? Yes X No  
If yes, show depth set feet  
If alternate 2 completion, cement circulated from feet depth to w/ SX cmt  
Cement Company Name  
Invoice # A/I

RECEIVED  
STATE CORPORATION COMMISSION  
JUN 24 1988  
CONSERVATION DIVISION  
Wichita, Kansas

INSTRUCTIONS: This form shall be completed in triplicate and filed with the Kansas Corporation Commission, 200 Colorado Derby Building, Wichita, Kansas 67202, within 120 days of the spud date of any well. Rule 82-3-130, 82-3-107 and 82-3-106 apply. Information on side two of this form will be held confidential for a period of 12 months if requested in writing and submitted with the form. See rule 82-3-107 for confidentiality in excess of 12 months. One copy of all wireline logs and drillers time log shall be attached with this form. Submit CP-4 form with all plugged wells. Submit CP-111 form with all temporarily abandoned wells.

All requirements of the statutes, rules and regulations promulgated to regulate the oil and gas industry have been fully complied with and the statements herein are complete and correct to the best of my knowledge.

Signature Anita Walker  
Title Operations Secretary Date 6/24/88

Subscribed and sworn to before me this 24th day of June 1988  
Notary Public Betty B. Herring  
Date Commission Expires 10-07-89

K.C.C. OFFICE USE ONLY  
Letter of Confidentiality Attached  
Wireline Log Received  
Drillers Timelog Received  
Distribution  
KCC SWD/Rep NGPA  
KGS Plug Other  
B.L.  
6-24-88  
Form ACO-1 (5-86)

BETTY B. HERRING  
NOTARY PUBLIC  
STATE OF KANSAS  
My Appt. Exp. 10-07-89

Sec 15 Twp 21 Rge 3