

STATE CORPORATION COMMISSION OF KANSAS
OIL & GAS CONSERVATION DIVISION
WELL COMPLETION OR RECOMPLETION FORM
ACO-1 WELL HISTORY
DESCRIPTION OF WELL AND LEASE

S

API NO. 15-113-21,203:0000

County McPherson

SW SW SW Sec 15 Twp 21 Rge 3 West

330 Ft North from Southeast Corner of Section
4950 Ft West from Southeast Corner of Section

(Note: Locate well in section plat below)


Lease Name Howard Kaufman Well # 3

Field Name PPL-Extension Washell

Producing Formation Mississippian

Elevation: Ground 1448 KB 1454

Section Plat

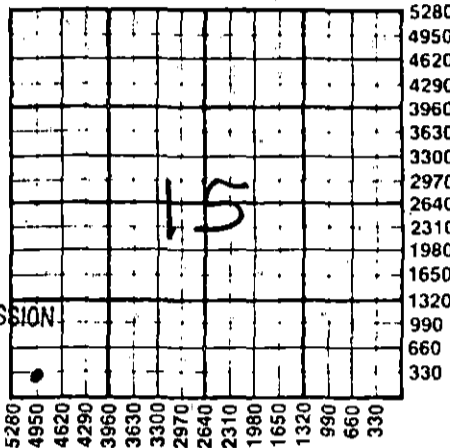

RECEIVED

JUL 22 1988

CONSERVATION DIVISION

WATER SUPPLY INFORMATION

Disposition of Produced Water: Disposal
Docket # Repressuring

Questions on this portion of the ACO-1 call:
Water Resources Board (913) 296-3717

Source of Water:
Division of Water Resources Permit #

Groundwater.....Ft North from Southeast Corner
(Well)Ft West from Southeast Corner of
Sec Twp Rge East West

Surface Water.....Ft North from Southeast Corner
(Stream,pond etc).....Ft West from Southeast Corner
Sec Twp Rge East West

Other (explain).....
(purchased from city, R.W.D. #)

Operator: License # 4569
Name Jay Boy Oil, Inc.
Address 535 Fourth Financial Center
City/State/Zip Wichita, KS 67202

Purchaser Koch
Wichita, KS

Operator Contact Person Gary Sharp
Phone (316) 264-3700

Contractor: License # 5418
Name Allen Drilling Company

Wellsite Geologist Steve Davis
Phone (316) 267-9115

Designate Type of Completion

X New Well Re-Entry Workover

X Oil SWD Temp Abd STATE CORPORATION COMMISSION
Gas Inj Delayed Comp.
Dry Other (Core, Water Supply etc.)

If OWO: old well info as follows:

Operator
Well Name
Comp. Date Old Total Depth

WELL HISTORY

Drilling Method:

X Mud Rotary Air Rotary Cable

03/25/88 03/29/88 04/14/88
Spud Date Date Reached TD Completion Date

3078' Total Depth
PBTD

Amount of Surface Pipe Set and Cemented at 231 @ 238 feet
Multiple Stage Cementing Collar Used? Yes X No
If yes, show depth set.....feet
If alternate 2 completion, cement circulated
from.....feet depth to.....w/.....SX cmt
Cement Company Name
Invoice #

A.B.I

INSTRUCTIONS: This form shall be completed in triplicate and filed with the Kansas Corporation Commission, 200 Colorado Derby Building, Wichita, Kansas 67202, within 120 days of the spud date of any well. Rule 82-3-130, 82-3-107 and 82-3-106 apply. Information on side two of this form will be held confidential for a period of 12 months if requested in writing and submitted with the form. See rule 82-3-107 for confidentiality in excess of 12 months. One copy of all wireline logs and drillers time log shall be attached with this form. Submit CP-4 form with all plugged wells. Submit CP-111 form with all temporarily abandoned wells.

All requirements of the statutes, rules and regulations promulgated to regulate the oil and gas industry have been fully complied with and the statements herein are complete and correct to the best of my knowledge.

Signature Anita Walker

Title Operations Secretary Date 7/21/88

Subscribed and sworn to before me this 21 day of July 1988

Notary Public Betty B. Herring

Date Commission Expires 10-07-89

BETTY B. HERRING
NOTARY PUBLIC
STATE OF KANSAS
My Appt. Exp. 10-07-89

K.C.C. OFFICE USE ONLY
Letter of Confidentiality Attached
Wireline Log Received
Drillers Time log Received
Distribution
KCC SWD/Rep NGPA
KGS Plug Other
(Specify)
7-22-88 X

Sec. 15 Twp. 21 Rge. 3 W