

STATE OF KANSAS
STATE CORPORATION COMMISSION


Form CP-4

Give All Information Completely
Make Required Affidavit
Mail or Deliver Report to:
Conservation Division
State Corporation Commission
211 No. Broadway
Wichita, Kansas

WELL PLUGGING RECORD

Rush County, Sec. 3 Twp. 16 Rge. 19 (X) W (W)

Location as "NE/CNW/SW" or footage from lines C NW NE
Lease Owner: Donald C. Slawson
Lease Name: Seelye 'A' Well No. 2
Office Address: 408 One Twenty Building - Wichita, Kansas
Character of Well (completed as Oil, Gas or Dry Hole) Dry
Date well completed 8-1 1964
Application for plugging filed 7-31 1964
Application for plugging approved 7-31 1964
Plugging commenced 8-1 1964
Plugging completed 8-1 1964
Reason for abandonment of well or producing formation Dry

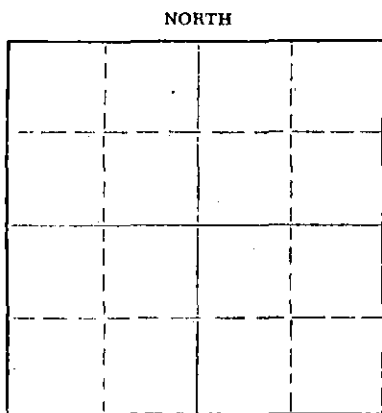

Locate well correctly on above
Section Plat

If a producing well is abandoned, date of last production 19
Was permission obtained from the Conservation Division or its agents before plugging was commenced? Yes

Name of Conservation Agent who supervised plugging of this well Eldon Petty
Producing formation _____ Depth to top _____ Bottom _____ Total Depth of Well 3602 Feet
Show depth and thickness of all water, oil and gas formations.

OIL, GAS OR WATER RECORDS

CASING RECORD

FORMATION	CONTENT	FROM	TO	SIZE	PUT IN	PULLED OUT
				8 5/8"	490'	None

Describe in detail the manner in which the well was plugged, indicating where the mud fluid was placed and the method or methods used in introducing it to the hole. If cement or other plugs were used, state the character of same and depth placed, from _____ feet to _____ feet for each plug set.

Fill with mud 3602' up to 490', mixed 30 sks cement.
Fill with mud 400' up to 210', mixed 30 sks cement.
Fill with mud 120' up to 35', mixed 10 sks cement.

RECEIVED
STATE CORPORATION COMMISSION
AUG 14 1964
CONSERVATION DIVISION
Wichita, Kansas

(If additional description is necessary, use BACK of this sheet)
Name of Plugging Contractor Slawson Drilling Company, Inc.
Address 408 One Twenty Building - Wichita, Kansas

STATE OF Kansas, COUNTY OF Sedgwick, ss.
Donald C. Slawson (employee of owner) or (owner or operator) of the above-described

well, being first duly sworn on oath, says: That I have knowledge of the facts, statements, and matters herein contained and the log of the above-described well as filed and that the same are true and correct. So help me God.

(Signature) [Signature]
408 One Twenty Building - Wichita, Ks.
(Address)

SUBSCRIBED AND SWORN to before me this 13th day of August, 1964

My commission expires August 25, 1964 Ella Priess Notary Public.

WELL LOG

Company: Donald C. Slawson
 408 One Twenty Building
 Wichita, Kansas

Farm: Seelye 'A' #2
 C NW NE, Section 3-16-19W
 Rush County, Kansas

Total Depth: 3602' Elevation: 2011 K. B.

Commenced: July 21, 1964
 Completed: August 1, 1964

Contractor: Slawson Drilling Company, Inc.

Casing: 8-5/8" @ 490' w/325 sacks cement

0-20	Surface Clay
20-560	Shale and shells
560-1247	Sand and shale
1247-1906	Shale
1906-2042	Lime and shale
2042-2053	Sand
2053-2251	Lime and shale
2251-2405	Lime
2405-2965	Lime and shale
2965-2980	Lime
2980-3170	Lime and shale
3170-3602	Lime


RECEIVED
 STATE CORPORATION COMMISSION
 AUG 14 1964
 CONSERVATION DIVISION
 Wichita, Kansas

STATE OF KANSAS)
) SS:
 COUNTY OF SEDGWICK)

I, DONALD C. SLAWSON, of the Slawson Drilling Company, Inc., upon oath state that the above and foregoing is a true and correct copy of the log of the Seelye 'A' #2 well.


 Donald C. Slawson

Subscribed and sworn to before me this 13th day of August, 1964.


 Ella Priess, Notary Public

My Commission Expires:
 August 25, 1964