


WELL PLUGGING RECORD

Give All Information Completely
Make Required Affidavit
Mail or Deliver Report to:
Conservation Division
State Corporation Commission
212 No. Market
Wichita, Kansas

NORTH

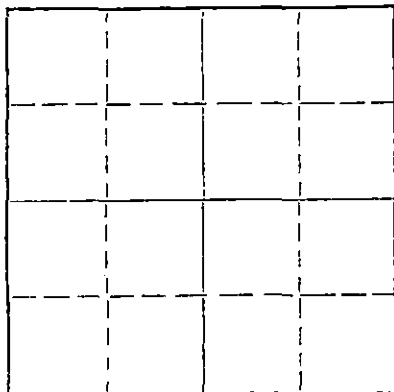

Locate well correctly on above
Section Plat

Hodgeman County. Sec. 21 Twp 21S Rge. (E) 21 (W)
Location as "NE/CNW&SW" or footage from lines Approx. NE NE
Lease Owner Beardmore Drilling Company
Lease Name WATERHOUSE "A" Well No. 2
Office Address 700 One Twenty Bldg. - Wichita, Kansas
Character of Well (completed as Oil, Gas or Dry Hole) Dry Hole
Date well completed 4-16 19 67
Application for plugging filed 4-16 19 67
Application for plugging approved 4-16 19 67
Plugging commenced 4-16 19 67
Plugging completed 4-16 19 67
Reason for abandonment of well or producing formation No oil or gas found
in commercial quantities.
If a producing well is abandoned, date of last production -- 19 --
Was permission obtained from the Conservation Division or its agents before plugging was com-
menced? Yes

Name of Conservation Agent who supervised plugging of this well Ed Eaves, Sublette, Kansas
Producing formation None Depth to top _____ Bottom _____ Total Depth of Well 4314 Feet
Show depth and thickness of all water, oil and gas formations.

OIL, GAS OR WATER RECORDS

CASING RECORD

FORMATION	CONTENT	FROM	TO	SIZE	PUT IN	PULLED OUT
				8-5/8"	392'	-0-

Describe in detail the manner in which the well was plugged, indicating where the mud fluid was placed and the method or methods used in introducing it into the hole. If cement or other plugs were used, state the character of same and depth placed, from _____ feet to _____ feet for each plug set.

Pushed plug to 700' and pumped 30 sacks cement through drill pipe. Spotted 30 sacks at 440'. Mud back to 45', set solid bridge and capped with 15 sacks, 2 sacks in rat hole. Plugging completed at 11:00 A.M., 4-16-67.

RECORDED
STATE CORPORATION COMMISSION

APR 24 1967

CONSERVATION DIVISION
Wichita, Kansas

(If additional description is necessary, use BACK of this sheet)
Name of Plugging Contractor Rains & Williamson Oil Co., Inc.
Address 1425 Wichita Plaza - Wichita, Kansas 67202

STATE OF KANSAS, COUNTY OF SEDGWICK, ss.
Wilson Rains (employee of owner) or ~~(owner or operator)~~ of the above-described well, being first duly sworn on oath, says: That I have knowledge of the facts, statements, and matters herein contained and the log of the above-described well as filed and that the same are true and correct. So help me God.

(Signature) Wilson Rains Wilson Rains
1425 Wichita Plaza - Wichita, Kansas
(Address)

SUBSCRIBED AND SWORN TO before me this 18 day of April, 19 67

My commission expires March 3, 1970 Mary J. Brown Notary Public.

ROTARY DRILLING LOG

15.083.20007.0000

Operator: Beardmore Drilling Company
#2 WATERHOUSE "A"
Approx. NE NE Sec. 21-21S-21W
Hodgeman County, Kansas

Contractor: Rains & Williamson
Oil Co., Inc.
Commenced: 4-6-67
Completed: 4-16-67

Formations:

Soil and Clay	40'
Sand	130'
Shale and Red Bed	190'
Sand	230'
Shale and Shells	395'
Shale	450'
Red Bed	613'
Blaine Anhydrite	622'
Shale and Red Bed	707'
Sand	890'
Shale	1125'
Shale and Red Bed	1262'
Anhydrite	1292'
Shale and Shells	1575'
Shale and Salt	1655'
Shale	2005'
Shale and Lime	2220'
Lime	2665'
Shale and Lime	2880'
Lime and Shale	3685'
Lime	4115'
Lime and Conglomerate	4176'
Lime	4285'
Lime and Conglomerate	4304'
Mississippi Lime	4314'
Rotary Total Depth (D & A)	4314'


Remarks: Set 8-5/8" surface casing at 392' w/225 sacks common, 2% Ca.Cl.

We certify the above log is true and correct to the best of our knowledge and belief.

RAINS & WILLIAMSON OIL CO., INC.


Wilson Rains

Subscribed and sworn to before me, a Notary Public in and for the State of Kansas, County of Sedgwick, this 18th day of April, 1967.

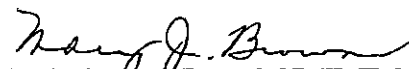
Mary J. Brown Notary Public

My Commission Expires:
March 3, 1970