


STATE OF KANSAS
STATE CORPORATION COMMISSION

WELL PLUGGING RECORD

Give All Information Completely
Make Required Affidavit
Mail or Deliver Report to
Conservation Division
State Corporation Comm.
245 North Water
Wichita, KS 67202

McPherson County, Sec. 8 Twp. 21 Rge. 2 K/W
Location as "NE/CNW/SW" or footage from lines
NE NE SW

Lease Owner Barnett Oil Co.
Lease Name Gehring Well No. "1-B"
Office Address
Character of Well (Completed as Oil, Gas or Dry Hole)

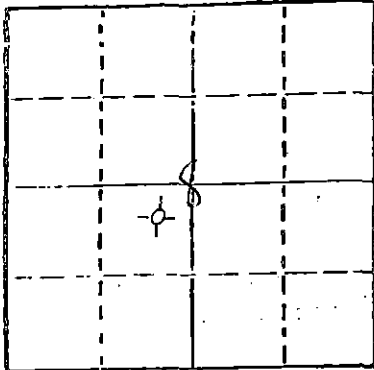

Locate well correctly on above Section Plot

Date Well completed 9-13- 1977
Application for plugging filed 9-13-7 1977
Application for plugging approved 9-13- 1977
Plugging commenced 9-13- 1977
Plugging completed 8:00 P.M. 9-13- 1977

Reason for abandonment of well or producing formation
Dry hole

If a producing well is abandoned, date of last production 19

Was permission obtained from the Conservation Division or its agents before plugging was commenced? Yes

Name of Conservation Agent who supervised plugging of this well Hugh Scott
Producing formation Depth to top Bottom Total Depth of Well 3120
Show depth and thickness of all water, oil and gas formations.

OIL, GAS OR WATER RECORDS

CASIN RECORD

FORMATION	CONTENT	FROM	TO	SIZE	PUT IN	PULLED OUT
				8 5/8	211'	

Describe in detail the manner in which the well was plugged, indicating where the mud fluid was placed and the method or methods used in introducing it into the hold. If cement or other plugs were used, state the character of same and depth placed, from feet to feet for each plug set. Mudded hole to @ 200 KB; set 8 5/8" plug and applied 25 sx. Class A common. Mudded hole to 40 KB and applied 10 sx. Class A common. Put 2 sx Class A common in rat hole.

(If additional description is necessary, use BACK of this sheet)
Name of Plugging Contractor Kan Go, Inc.

STATE OF Kansas COUNTY OF McPherson
Frank S. Mize (employee of owner) or (owner or operator) of the above-described

well, being first duly sworn on oath, says: That I have knowledge of the facts, statements, and matters herein contained and the log of the above-described well as filed and that the same are true and correct. So help me God.

(Signature) Frank S. Mize
Box 277 Marion, Kansas 66861
(Address)

Subscribed and sworn to before me this 23rd day of September 1977

My commission expires October 11, 1980

Cynthia D. Ritzloff
Notary Public

