


WELL PLUGGING RECORD

Give All Information Completely
Make Required Affidavit
Mail or Deliver Report to:
Conservation Division
State Corporation Commission
212 No. Market
Wichita, Kansas

NORTH

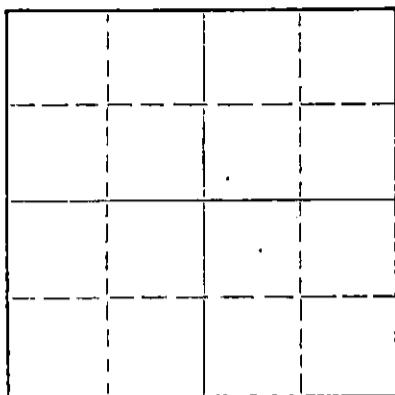

Locate well correctly on above
Section Plat

McPherson County, Sec. 36 Twp. 21S Rge. (E) 2 (W)
Location as "NE/CNW/SW" or footage from lines NE NE NE
Lease Owner B. E. Shelton
Lease Name Loganbill Well No. 1
Office Address 102 Insurance Building, Wichita, Kansas
Character of Well (completed as Oil, Gas or Dry Hole) Dry Hole
Date well completed October 16 1969
Application for plugging filed October 27 1969
Application for plugging approved 19
Plugging commenced October 16 1969
Plugging completed same 19
Reason for abandonment of well or producing formation Dry Hole

If a producing well is abandoned, date of last production 19
Was permission obtained from the Conservation Division or its agents before plugging was commenced? yes

Name of Conservation Agent who supervised plugging of this well Ted Dewey
Producing formation Depth to top Bottom Total Depth of Well 3498 Feet
Show depth and thickness of all water, oil and gas formations.


OIL, GAS OR WATER RECORDS

CASING RECORD

FORMATION	CONTENT	FROM	TO	SIZE	PUT IN	PULLED OUT

Describe in detail the manner in which the well was plugged, indicating where the mud fluid was placed and the method or methods used in introducing it into the hole. If cement or other plugs were used, state the character of same and depth placed, from feet to feet for each plug set.

Mud to 215', 1/2 sack hulls and 25 sacks cement;
mud to 40', 1/2 sack hulls, 10 sacks cement to surface;
2 sacks cement in rathole.

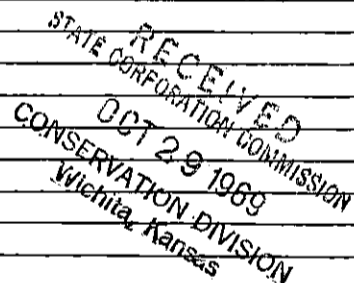

(If additional description is necessary, use BACK of this sheet)

Name of Plugging Contractor Aspen Drilling Co.
Address P. O. Box 783, Great Bend, Kansas

STATE OF Kansas COUNTY OF Barton, ss.
William S. Schachle (employee of owner) or (owner or operator) of the above-described well, being first duly sworn on oath, says: That I have knowledge of the facts, statements, and matters herein contained and the log of the above-described well as filed and that the same are true and correct. So help me God.

(Signature) William S. Schachle
William S. Schachle
P. O. Box 783, Great Bend, Kansas
(Address)

SWORN TO before me this 27th day of October, 1969



Theora Holleman
Notary Public.

DRILLERS LOG

COMPANY: B. E. Shelton
 CONTRACTOR: Aspen Drilling Co.
 LEASE NAME: Loganbill #1
 LOCATION: NE NE NE Sec. 36-T21S-R2W
 McPherson County, Kansas
 ELEVATION: 1484' K. B.
 SURFACE CASING: 5 jts. (216') 8 5/8"
 COMMENCED: 10-5-69
 COMPLETED: 10-15-69
 ROTARY TOTAL DEPTH: 3498'

<u>FORMATION</u>	<u>DEPTH</u>	
Sand & Shale	223	Ran 5 jts. (216') 8 5/8" set at 222'
Shale	324	w/175 sacks.
Shale & Lime	347	
Lime	405	Ran electric log.
Lime & Shale	1129	
Shale & Lime	1690	D & A
Lime & Shale	2237	
Sand	2415	
Shale & Lime	2469	
Shale & Sand	2490	
Shale & Lime	2680	
Lime & Shale	2972	
Shale & Lime	3069	
Lime	3240	
Lime & Chert	3245	
Lime	3282	
Lime & Chert	3317	
Lime & Shale	3342	
Lime	3395	
Shale	3444	
Chert	3453	
Lime	3470	
Lime & Shale	3498	
RTD	3498	

RECEIVED
 STATE CORPORATION COMMISSION
 OCT 29 1969
 CONSERVATION DIVISION
 Wichita, Kansas

AFFIDAVIT

State of Kansas)
) ss:
 County of Barton)

The undersigned, being duly sworn on oath, states that the above statement and log are a true and correct record and log of the well drilled at the location above described.

William S. Schachle
 William S. Schachle, Affiant

sworn to before me this 20th day of October, 1969.



Theora Holleman
 Theora Holleman, Notary Public

My commission expires: April 18, 1972.