


Give All Information Completely  
Make Required Affidavit  
Mail or Deliver Report to:  
Conservation Division  
State Corporation Commission  
211 No. Broadway  
Wichita, Kansas

WELL PLUGGING RECORD

McPherson County, Sec. 28 Twp. 21 S Rge. (E) 2 (W)

Location as "NE/CNW/SW" or footage from lines SE/4 SE/4 NE/4  
Lease Owner Messman-Rinehart Oil Company  
Lease Name Martin Goering Well No. 1  
Office Address 1432 Wichita Plaza Bldg., Wichita 2, Kansas  
Character of Well (completed as Oil, Gas or Dry Hole) Dry Hole  
Date well completed May 11 19 63  
Application for plugging filed May 11 19 63  
Application for plugging approved May 11 19 63  
Plugging commenced May 11 19 63  
Plugging completed May 11 19 63  
Reason for abandonment of well or producing formation Dry

NORTH

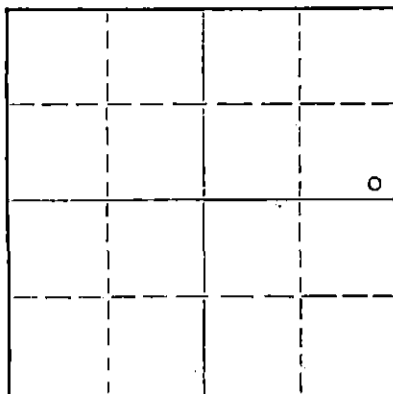

Locate well correctly on above  
Section Plat

If a producing well is abandoned, date of last production 19  
Was permission obtained from the Conservation Division or its agents before plugging was commenced? yes

Name of Conservation Agent who supervised plugging of this well Cecil Jones, 1114 N. Walnut, McPherson, Kansas

Producing formation Depth to top Bottom Total Depth of Well 3628 Feet

Show depth and thickness of all water, oil and gas formations.

OIL, GAS OR WATER RECORDS

CASING RECORD

FORMATION	CONTENT	FROM	TO	SIZE	PUT IN	PULLED OUT
				8-5/8"	250'	none

Describe in detail the manner in which the well was plugged, indicating where the mud fluid was placed and the method or methods used in introducing it into the hole. If cement or other plugs were used, state the character of same and depth placed, from feet to feet for each plug set.

Set plug at 240' with 1/4 sk. hulls and  
20 sx. cement. Set plug at 30' with 1/4 sk.  
hulls and 8 sx. cement

RECEIVED  
STATE CORPORATION COMMISSION

MAY 23 1963

CONSERVATION DIVISION  
Wichita, Kansas

(If additional description is necessary, use BACK of this sheet)

Name of Plugging Contractor Messman-Rinehart Oil Company  
Address 1432 Wichita Plaza Bldg., Wichita 2, Kansas

STATE OF Kansas COUNTY OF Sedgwick, ss.  
J. A. Gilliland (employee of owner) or (agent) of the above-described well, being first duly sworn on oath, says: That I have knowledge of the facts, statements, and matters herein contained and the log of the above-described well as filed and that the same are true and correct. So help me God.

(Signature) J. A. Gilliland  
1432 Wichita Plaza Bldg., Wichita 2, Kansas  
(Address)

SUBSCRIBED AND SWORN TO before me this 22nd day of May, 1963

Barbara J. Scott  
Notary Public.

My commission expires December 1, 1964



NO. 1 MARTIN GOERING

Well Record:

Location: SE/4 SE/4 NE/4 Section 28-215-2W  
 McPherson County, Kansas  
 Commenced: April 26, 1963  
 Completed: May 11, 1963  
 Operator: Messman-Rinehart Oil Company  
 1432 Wichita Plaza Bldg.  
 Wichita 2, Kansas  
 Elevation: 1460' K/B  
 Production: D & A  
 Contractor: Messman-Rinehart Oil Company  
 1432 Wichita Plaza Bldg.  
 Wichita 2, Kansas  
 Casing Record: 8-5/8" @ 250' w/180 sx. cement

\*\*\* LOG \*\*\*

Sand and Clay 60  
 Shale & Shells 300  
 Lime & Shells 479  
 Lime 1115  
 Lime & Shale 2330  
 Lime 2785  
 Lime & Shale 2855  
 Shale 3022  
 Lime (Miss.) 3035  
 Lime & Chert 3050  
 Lime (Cherty) 3070  
 Lime Chert 3077  
 Lime & Chert 3100  
 Lime (Cherty) 3150  
 Lime & Chert 3220  
 Lime 3289  
 Lime & Shale 3330  
 Shale & Lime 3400  
 Lime & Shale 3520  
 Lime & Sand 3552  
 Sand 3555  
 Shale & Sand 3590  
 Sand 3611  
 Lime (Arbuckle) 3628 R.T.D.

Sample Tops:

1935' - Topeka (-467')  
 2082' - Heebner (-614')  
 2105' - Douglas (-637')  
 2344' - Lansing (-876')  
 2855' - Mississippian (-1554')  
 3394' - Welsner (-1926')  
 3396' - Hunton (-1928')  
 3415' - Maquoketa (-1947')  
 3505' - Viola (-2037')  
 3538' - Simpson (-2070')  
 3611' - Arbuckle (-2143')

**RECEIVED**  
 STATE CORPORATION COMMISSION  
 MAY 23 1963  
 CONSERVATION DIVISION  
 Wichita, Kansas

The undersigned, MESSMAN-RINEHART OIL COMPANY, hereby certifies that the above log is a true and correct log of the formation encountered in drilling the above well as reflected by the Daily Drilling Reports.

MESSMAN-RINEHART OIL COMPANY

By: J. A. Gilliland  
 J. A. Gilliland, Office Manager

Subscribed and sworn to before me this 22nd day of May, 1963

Barbara J. Scott  
 Barbara J. Scott, Notary Public

My Commission Expires: December 1, 1964