


STATE OF KANSAS
STATE CORPORATION COMMISSION
200 Colorado Derby Bldg.
Wichita, Kansas 67202

Form CP-4
Rev. 12-15-80

WELL PLUGGING RECORD

Give All Information Completely
Make Required Affidavit

COUNTY McPherson SEC. 17 TWP. 31S RGE. 3 NW
Location as in quarters or footage from lines:
20'E of C NE NE

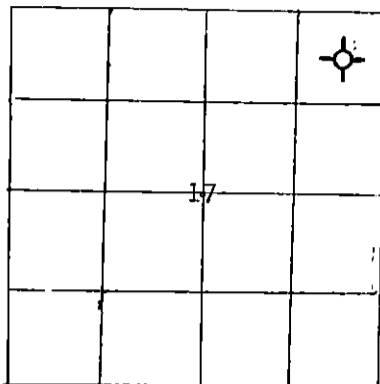

Locate Well
correctly on above
Section Platt.

Lease Owner Wild Boys & The Silver Bullet
Lease Name VOSHELL WEST Well No. 1A
Office Address 815 N. Waco, Suite 3A, Wichita, Ks.
Character of Well (Completed as Oil, Gas or Dry Hole): Dry Hole
Date Well Completed 11-24-81
Application for plugging filed February 3, 1981
Plugging commenced 11-24-81
Plugging completed 11-24-81
Reason for abandonment of well or producing formation Non-commercial

Was permission obtained from the Conservation Division or it's
Agent's before plugging was commenced? Yes

Name of Conservation Agent who supervised plugging of this well Merlin Unruh

Producing formation N/A Depth to top _____ bottom _____ T.D. 3900'

Show depth and thickness of all water, oil and gas formations.

OIL, GAS OR WATER RECORDS

Casing Record

Formation	Content	From	To	Size	Put in	Pulled Out
Lansing		2538		13 3/8"	275'	
Mississippi		3235		8 5/8"	933'	
Viola		3746				
Simpson		3782				
Arbuckle		3850				

Describe in detail the manner in which the well was plugged, indicating where the mud
fluid was placed and the method or methods used in introducing it into the hold. If cement
or other plugs were used, state the character of same and depth placed, from _____ feet
to _____ feet for each plug set.

30 sx cement at 900', bridge plug and 10 sx at 40', 5 sx in rathole and 5 sx in
mousehole.
Common cement + no additive pumped into place.
Cement plug from 900' to 814', wooden plug at 40' and solid cement from 40' to
surface.
Mud fluids are left in pits and backfilled when sufficiently dry.

RECEIVED
STATE CORPORATION COMMISSION

FEB - 4 1982

(If additional description is necessary, use BACK of this sheet)
Name of Plugging Contractor Halliburton Services CONSERVATION DIVISION
Wichita, Kansas

STATE OF Kansas COUNTY OF Sedgwick, ss.
R. A. Christensen (employee of owner) or (owner or operator) of the
above-described well, being first duly sworn on oath, says: That I have knowledge of the
facts, statements, and matters herein contained and the log of the above-described well as
filed and that the same are true and correct. So help me God.

(Signature) R.A. Christensen
(Address) _____

SUBSCRIBED AND SWORN TO before me this 3rd day of February, 1982

Donna Hale Ard
Notary Public.

My Commission expires: October 29, 1982

DONNA HALE ARD
STATE NOTARY PUBLIC
SEDGWICK COUNTY, KANSAS