


STATE OF KANSAS
STATE CORPORATION COMMISSION

WELL PLUGGING RECORD

Give All Information Completely
Make Required Affidavit
Mail or Deliver Report to
Conservation Division
State Corporation Comm.
245 North Water
Wichita, KS 67202

Hodgeman County. Sec. 12 Twp. 21S Rge. 25 ~~XX~~/W
Location as "NE/CNW $\frac{1}{4}$ SW $\frac{1}{4}$ " or footage from lines
C SE SW

Lease Owner Kewanee Oil Company
Lease Name Miner Well No. 2
Office Address P. O. Box 2093, Wichita, Kansas 67201
Character of Well (Completed as Oil, Gas or Dry Hole)
Dry Hole

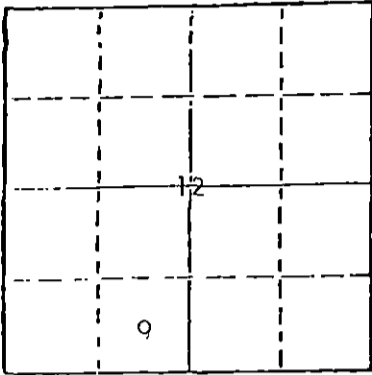

Locate well correctly on above
Section Plat

Date Well completed 19
Application for plugging filed 5-12 1977
Application for plugging approved Verbal 5-7 1977
Plugging commenced 5-8 1977
Plugging completed 5-8 1977
Reason for abandonment of well or producing formation
Non-Productive - dry

If a producing well is abandoned, date of last production
19

Was permission obtained from the Conservation Division or
its agents before plugging was commenced? Yes - Verbal

Name of Conservation Agent who supervised plugging of this well Clarence Thomas
Producing formation none Depth to top Bottom Total Depth of Well 4465
Show depth and thickness of all water, oil and gas formations.

OIL, GAS OR WATER RECORDS

CASING RECORD

FORMATION	CONTENT	FROM	TO	SIZE	PUT IN	PULLED OUT
				8-5/8"	478'	None

Describe in detail the manner in which the well was plugged, indicating where the mud fluid
was placed and the method or methods used in introducing it into the hold. If cement or other
plugs were used, state the character of same and depth placed, from feet to
feet for each plug set.

Plugged with 50-50 Pozmix, 2% gel, as follows:

- 50 sacks from 900' to 714'
- Mud from 714' to 480'
- 35 sacks from 480' to 357'
- Mud from 357' to 40'
- 15 sacks from 40' to surface
- Plugged rat hole with 5 sacks

RECEIVED
STATE CORPORATION COMMISSION

MAY 17 1977

CONSERVATION DIVISION
Wichita, Kansas

(If additional description is necessary, use BACK of this sheet)

Name of Plugging Contractor Gabbert-Jones, Inc.

STATE OF Kansas COUNTY OF Sedgwick, ss.
A. A. Lollar (employee of owner) ~~owner~~

of the above-described well, being first duly sworn on oath, says: That I have knowledge of
the facts, statements, and matters herein contained and the log of the above-described well
as filed and that the same are true and correct. So help me God.

(Signature) AA Lollar

P.O. Box 2093, Wichita, Kansas 67201
(Address)

SUBSCRIBED AND SWORN TO before me this 16th day of May, 19 77

Billie Oden
Notary Public.

My commission expires August 10, 1979

GABBERT-JONES, INC.
 WICHITA, KANSAS
 DRILLERS' WELL LOG

Miner #2
 1980 FSL & 660' FWL Sec 12-21S-25W
 Hodgeman County Kansas

Commenced: 4-27-77

Completed: 5-8-77

OPERATOR: KEWANEE OIL CO.

Depth	Formation	Remarks
From to		
0 285	Surface Clay-Sand	Ran 12 jts of New 20# 8 5/8"
285 487	Sand-Shale	csg set @ 482' Centralizer
487 560	Shale	@ 44-442-476' Cemented
560 1020	Shale-Sand	w/150 sks Halcolite - 130 sks
1020 1208	Sand	Common 3% CC
1208 1280	Redbed-Shale	PD @ 1:30 a.m. 4-28-77
1280 1729	Shale	
1729 2070	Shale-Shells	
2070 2399	Shale-Lime	
2399 4130	Lime-Shale	
4130 4390	Lime	
4390 4410	Lime-Shale	
4410 4465	Lime	DRY & ABANDONED
4465 - TD		

STATE OF KANSAS)
) SS
 COUNTY OF SEDGWICK)

I, the undersigned, being duly sworn on oath, state that the above Drillers' Well Log is true and correct to the best of my knowledge and belief and according to the records of this office.

GABBERT-JONES, INC.

James S. Sutton II
 JAMES S. SUTTON II

Subscribed and sworn to before me this 11th day of May, 1977.

Elizabeth J. Edwards
 ELIZABETH J. EDWARDS-NOTARY PUBLIC

My Commission expires February 6, 1979.

