

STATE OF KANSAS
STATE CORPORATION COMMISSION


WELL PLUGGING RECORD

Give All Information Completely
Make Required Affidavit
Mail or Deliver Report to:
Conservation Division
State Corporation Commission
800 Bittling Building
Wichita, Kansas

Stafford County, Sec. 31 Twp. 21S Rge. 11W (W)

Location as "NE/CNW $\frac{1}{4}$ SW $\frac{1}{4}$ " or footage from lines NE NE SE
Lease Owner Black Cat Oil Company
Lease Name Mellies "B" Well No. 1
Office Address Box 62, Great Bend, Kansas
Character of Well (completed as Oil, Gas or Dry Hole) Dry Hole
Date well completed May 1 19 51
Application for plugging filed May 3 19 51
Application for plugging approved May 4, 19 51
Plugging commenced May 1 19 51
Plugging completed May 1 19 51
Reason for abandonment of well or producing formation Dry Hole

NORTH

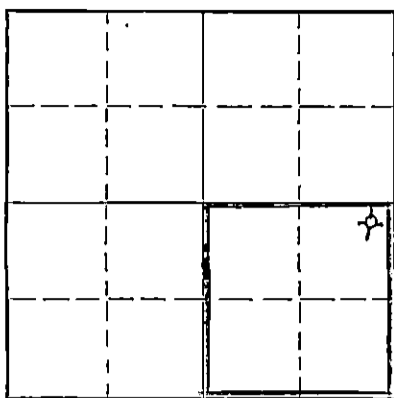

Locate well correctly on above Section Flat

If a producing well is abandoned, date of last production 19
Was permission obtained from the Conservation Division or its agents before plugging was commenced? Yes

Name of Conservation Agent who supervised plugging of this well Mr. C.D. Stough
Producing formation ----- Depth to top ----- Bottom ----- Total Depth of Well 3606 Feet
Show depth and thickness of all water, oil and gas formations.

OIL, GAS OR WATER RECORDS

CASING RECORD

| Formation | Content | From | To | Size | Put In | Pulled Out |
|-----------|---------|------|----|--------|--------|------------|
| | | | | 8-5/8" | 160' | X X X |
| | | | | | | |
| | | | | | | |
| | | | | | | |
| | | | | | | |
| | | | | | | |
| | | | | | | |
| | | | | | | |
| | | | | | | |

Describe in detail the manner in which the well was plugged, indicating where the mud fluid was placed and the method or methods used in introducing it into the hole. If cement or other plugs were used, state the character of same and depth placed, from ----- feet to ----- feet for each plug set.

Filled hole with heavy mud up to 160';
set bottom plug @ 155'; cemented with
15 sacks of cement; set top plug @ 40';
cemented with 10 sacks cement; cemented
rat hole with 5 sacks cement.

(If additional description is necessary, use BACK of this sheet)

Correspondence regarding this well should be addressed to Black Cat Oil Company
Address Box 62, Great Bend, Kansas

STATE OF KANSAS, COUNTY OF BARTON, ss.
Leon F. Huff, Partner of (employee or owner) or (owner or operator) of the above-described well,
being first duly sworn on oath, says: That I have knowledge of the facts, statements, and matters herein contained and the log of the above-described well as filed and that the same are true and correct. So help me God.

(Signature) Leon F. Huff
Box 62, Great Bend, Kansas
(Address)

SUBSCRIBED AND SWORN to before me this 3rd day of May, 1951

Mildred Wallace
Notary Public.

My commission expires March 6, 1954

PLUGGING
FILE SEC 31 T 21 R 11W
BOOK PAGE 79 LINE 89

MAY 6 1951

DRIER'S LOG

OPERATOR: Black Cat Oil Company
 FARM NAME: Mellies "B"
 WELL NUMBER: # 1
 Location: NE NE SE Sec. 31-21-11W
 Stafford County, Kansas
 CONTRACTOR: Black Cat Oil Company
 Casing Record: 8-5/8" @ 160'; cemented w/125 sacks cement and 1 sack calcium chloride.
 ROTARY COMMENCED: April 19, 1951
 ROTARY COMPLETED: May 1, 1951
 Initial Production: DRY
 ELEVATION: 1753' DF

Figures denote bottom of formation

| | |
|-----------------------|-------|
| Sand | 60 |
| Shale and Pyrite Iron | 95 |
| Red Bed and Shells | 475 |
| Anhydrite | 510 |
| Shale | 560 |
| Red Bed and Shale | 960 |
| Shale and Shells | 1,195 |
| Lime and Shale | 1,390 |
| Bro. Lime | 1,475 |
| Lime and Shale | 1,680 |
| Shale and Shells | 1,815 |
| Lime and Shale | 1,910 |
| Lime | 1,990 |
| Shale and Shells | 2,250 |
| Lime and Shale | 2,395 |
| Shale and Shells | 2,490 |
| Shale and Lime | 2,575 |
| Lime and Shale | 2,885 |
| Lime | 3,130 |
| Lime and Shale | 3,205 |
| Bro. Lime | 3,260 |
| Lime | 3,446 |
| Conglomerate | 3,606 |

Rotary Total Depth

CERTIFICATE

STATE OF KANSAS }
 BARTON COUNTY } 33

I hereby certify that the foregoing is, to the best of my knowledge and belief, a full, true and correct drilling log as shown by the daily drilling reports in connection with the afore said well.

PLUGGING
 FILE SEC 31 T 21 R 11W
 BOOK PAGE 79 LINE 29

Leon F. Huff
 Leon F. Huff
 Partner of Black Cat Oil Company

Subscribed and sworn to before me, the undersigned, a Notary Public, this 3rd day of May, 1951.

RECEIVED
 OPERATIONS COMMISSION
 MAY 8 - 1951
Mildred Hobbs
 Mildred Hobbs
 Notary Public

My commission expires March 6, 1954. VARIOUS DIVISION
 Wichita, Kansas