


WELL PLUGGING RECORD

Give All Information Completely  
Make Required Affidavit  
Mail or Deliver Report to:  
Conservation Division  
State Corporation Commission  
800 Bitting Building  
Wichita, Kansas

Stafford County. Sec. 31 Twp. 21 Rge. 11 (E) (W)

Location as "NE/CNW $\frac{1}{4}$ /SW $\frac{1}{4}$ " or footage from lines SE NW NE  
Lease Owner Duke & Wood Drilling Co., Inc.  
Lease Name Mellies Well No. 2  
Office Address P. O. Box 194, Great Bend, Kansas  
Character of Well (completed as Oil, Gas or Dry Hole) Dry Hole  
Date well completed January 22, 19 51  
Application for plugging filed January 22, 19 51  
Application for plugging approved January 22, 19 51  
Plugging commenced January 22, 19 51  
Plugging completed January 22, 19 51  
Reason for abandonment of well or producing formation Dry

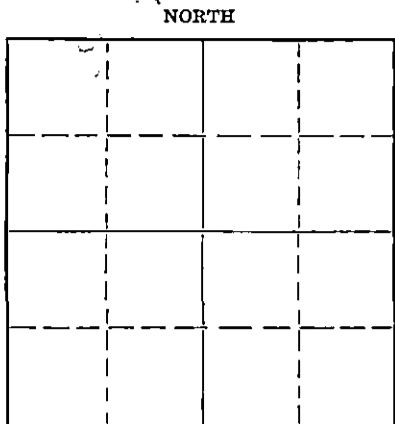

Locate well correctly on above Section Plat

If a producing well is abandoned, date of last production 19...  
Was permission obtained from the Conservation Division or its agents before plugging was commenced? yes

Name of Conservation Agent who supervised plugging of this well C. D. Stough  
Producing formation Depth to top Bottom Total Depth of Well 3550 Feet  
Show depth and thickness of all water, oil and gas formations.

OIL, GAS OR WATER RECORDS

CASING RECORD

Formation	Content	From	To	Size	Put In	Pulled Out
				8 5/8"	217'	None

Describe in detail the manner in which the well was plugged, indicating where the mud fluid was placed and the method or methods used in introducing it into the hole. If cement or other plugs were used, state the character of same and depth placed, from feet to feet for each plug set.

Filled hole with heavy mud to 210'. Set plug. Dumped 15 sacks cement on same, filled to 30'. Set 2nd plug at 30'. Dumped 10 sacks cement on same filling to bottom of cellar.

RECEIVED  
STATE CORPORATION COMMISSION  
FEB 19 1951  
CONSERVATION DIVISION  
Wichita, Kansas

(If additional description is necessary, use BACK of this sheet)

Correspondence regarding this well should be addressed to Duke & Wood Drilling Co., Inc.  
Address P. O. Box 194 Great Bend, Kansas

STATE OF KANSAS, COUNTY OF BARTON, ss.  
Lynn O. Duke (employee of owner, operator or operator) of the above-described well, being first duly sworn on oath, says: That I have knowledge of the facts, statements, and matters herein contained and the log of the above-described well as filed and that the same are true and correct. So help me God.


(Signature) *Lynn O. Duke*  
P. O. Box 194 Great Bend, Kansas (Address)

SUBSCRIBED AND SWORN TO before me this 8th day of February, 19 51

*Dean E. Cooley* Notary Public.

My commission expires 29, 1953

22-7877-B 4-49-10M

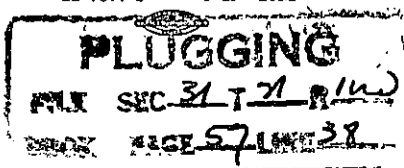

WELL LOG  
Melliss #2  
SE NW NE Section 21-21-11  
Stafford County, Kansas

Started January 11, 1951  
Completed January 22, 1951

Anhydrite - 508'  
Heebner - 3026' (-1260)  
Brown Lime- 3155' (-1389)  
Kansas City - 3171' (-1405)  
Conglomerate - 3474' (-1708)

0-140	Sand and red rock
140-217	Sand, red rock and red bed
217-508	Sand and red bed
508-640	Anhydrite, shale and shells
640-1030	Red bed, shale and shells
1030-1435	Salt, shale and shells
1435-1570	Shale, shells and lime
1570-1775	Lime and shale
1775-2235	Lime and shale
2235-2840	Lime and shale
2840-3020	Lime and shale
3020-3185	Lime and shale
3185-3375	Lime
3375-3481	Lime
3481-3550	Conglomerate

3550 TOTAL ROTARY DEPTH

A F F I D A V I T

STATE OF Kansas, COUNTY OF Barton. SS

I, Lynn O. Duke, of the DUKE & WOOD DRLG. Company, INC. being first duly sworn on oath, state; That I have knowledge of the facts, statements and matters herein contained and that the same are true and correct.

RECEIVED  
STATE CORPORATION COMMISSION  
FEB 19 1951  
CONSERVATION DIVISION  
Wichita, Kansas

Lynn O. Duke  
Vice-President

Subscribed and sworn to before me this 17 day of February 1951.

PLUGGING  
FILE SEC 31 T 21 R 11W  
BOOK PAGE 57 LINE 34

Dean L. Cooley  
Notary Public

My commission expires: April 29, 1953