


WELL PLUGGING RECORD

Give All Information Completely
Make Required Affidavit
Mail or Deliver Report to:
Conservation Division
State Corporation Commission
211 No. Broadway
Wichita, Kansas

Stafford County, Sec. 31 Twp. 21 Rge. 11 (E) (W)

Location as "NE/CNW&SW" or footage from lines SE SW SW
Lease Owner Altman Petroleum Company & Sylvan Producing
Lease Name Mellies A Well No. 1
Office Address 810 Midstates Bldg. Tulsa, Oklahoma
Character of Well (completed as Oil, Gas or Dry Hole) dry
Date well completed 1-8 19 57
Application for plugging filed 1-8 19 57
Application for plugging approved 1-8 19 57
Plugging commenced 10:30 A.M. 1-8 19 57
Plugging completed 12:30 1-8 19 57
Reason for abandonment of well or producing formation

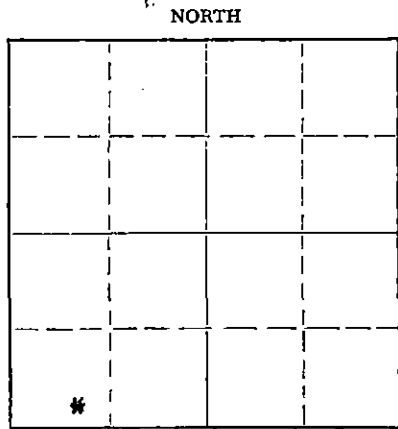

Locate well correctly on above Section Plat

If a producing well is abandoned, date of last production 19
Was permission obtained from the Conservation Division or its agents before plugging was commenced?

Name of Conservation Agent who supervised plugging of this well R. M. Brundege
Producing formation Depth to top Bottom Total Depth of Well 3605 Feet
Show depth and thickness of all water, oil and gas formations.

OIL, GAS OR WATER RECORDS

CASING RECORD

FORMATION	CONTENT	FRDM	TD	SIZE	PUT IN	PULLED OUT
Surface pipe		0	320.08	8 5/8	320.08	-0-

Describe in detail the manner in which the well was plugged, indicating where the mud fluid was placed and the method or methods used in introducing it into the hole. If cement or other plugs were used, state the character of same and depth placed, from feet to feet for each plug set.

Filled hole to 300° with heavy mud
Dumped 1/3 sack hulls
Ran plug to 300° w/D.P.
Cemented with 20 sacks cement on top of plug thru D.P.
Filled hole to 35° with heavy mud
Dumped 1/3 sacks and top plug to 35°
Cemented with 10 sacks cement
Cemented to cellar floor level.

(If additional description is necessary, use BACK of this sheet)

Name of Plugging Contractor A. L. Jackson Drilling Company
Address Box 194 Great Bend, Kansas

STATE OF Kansas COUNTY OF Barton, ss.
W. L. Luther (employee of owner) of the above-described well, being first duly sworn on oath, says: That I have knowledge of the facts, statements, and matters herein contained and the log of the above-described well as filed and that the same are true and correct. So help me God.

(Signature) [Signature]
Box 194 Great Bend, Kansas
(Address)

SUBSCRIBED AND SWORN to before me this 9th day of January, 19 57

[Signature]
Notary Public.

My commission expires 5-9-59

PLUGGING
FILE SEC 31 T 21 R 11 W
BOOK PAGE 132 LINE 30

RECEIVED
STATE CORPORATION COMMISSION

JAN 14 1957

CONSERVATION DIVISION
Wichita, Kansas

Well Log
 Mellies A-1
 SE SW SW 31-21-11
Stafford County, Kansas

0	-	50	Sand and clay
50	-	166	Shale and shells
166	-	226	Red bed and shells
226	-	320	Red bed and shale
320	-	750	Shale and shells
750	-	770	Red bed
770	-	800	Anhydrite
800	-	1440	Shale, shells & salt
1440	-	1480	Shale and shells
1480	-	1620	Lime, Fort Riley and shale
1620	-	1730	Fort Riley - lime
1730	-	1860	Lime and shale
1860	-	1890	Shale and lime
1890	-	2050	Shale and lime streaks
2050	-	2145	Shale and brown lime
2145	-	2240	Shale and shells
2240	-	2600	Shale and lime
2600	-	2785	Shale and shells
2785	-	3090	Lime and shale
3090	-	3167	Shale and lime
3167	-	3191	Shale
3191	-	3235	Lime Kansas City
3235	-	3420	Lime
3420	-	3467	Lime and shale
3467	-	3523	Lime conglomerate and shale
3523	-	3540	Conglomerate & dolomite
3540	-	3575	Simpson shale
3575	-	3605	Lime and conglomerate
3605	-		T. D.

Heebner: 3034°

STATE OF KANSAS
 COUNTY OF BARTON SS

Dick B. Evans, accountant for A. L. Jackson Drilling Company, being first duly sworn on oath, says: That I have knowledge of the facts, statements and matters herein contained and the log of the above described well as filed and that the same are true and correct.

Dick B. Evans
 Dick B. Evans

Subscribed and sworn before me this 10th day of January, 1957.

Virgil E. Belford, Jr.
 Virgil E. Belford, Jr.
 Notary Public Barton County

My commission expires: April 27, 1957.

PLUGGING			
FILE	SEC	31 21	11 W
BOOK	PAGE	130 11 E 21	30

RE
 STATE CORPORATE COMMISSION
 CONSERVATION DIVISION
 Wichita, Kansas