


STATE OF KANSAS
STATE CORPORATION COMMISSION

Give All Information Completely
Make Required Affidavit
Mail or Deliver Report to:
Conservation Division
State Corporation Commission
211 No. Broadway
Wichita, Kansas

WELL PLUGGING RECORD

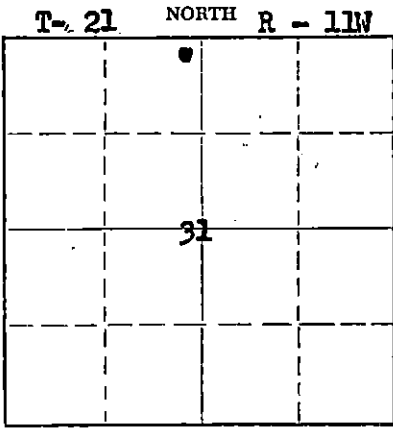

Locate well correctly on above
Section Plat

Stafford County. Sec. 31 Twp. 21 Rge. (E) 11 (W)
Location as "NE/CNW/SW" or footage from lines NE - NE - NW
Lease Owner: Frank J. Black
Lease Name: Mellies Well No. 1
Office Address: McPherson, Kansas
Character of Well (completed as Oil, Gas or Dry Hole) Oil
Date well completed Jan. 29 19 51
Application for plugging filed July 9 19 58
Application for plugging approved July 11 19 58
Plugging commenced July 17 19 58
Plugging completed July 21 19 58
Reason for abandonment of well or producing formation Unprofitable

If a producing well is abandoned, date of last production 19
Was permission obtained from the Conservation Division or its agents before plugging was commenced? Yes

Name of Conservation Agent who supervised plugging of this well Frank Brodfoot
Producing formation Depth to top Bottom Total Depth of Well 3526 Feet
Show depth and thickness of all water, oil and gas formations.

OIL, GAS OR WATER RECORDS

CASING RECORD

FORMATION	CONTENT	FROM	TO	SIZE	PUT IN	PULLED OUT
				8 5/8	218	None
				5 1/2	3523	3083.88

Describe in detail the manner in which the well was plugged, indicating where the mud fluid was placed and the method or methods used in introducing it into the hole. If cement or other plugs were used, state the character of same and depth placed, from feet to feet for each plug set.

Sanded off bottom to 3505' - dumped 5 sx cement - mudded hole to 220' - set 10' rock bridge - dumped 2 sx Cal Seal and 20 sx cement - mudded to 40' - set 10' rock bridge - dumped 10 sx cement.

(If additional description is necessary, use BACK of this sheet)

Name of Plugging Contractor R & D casing Pulling Company License # 236
Address Box 569 Ellinwood, Kansas

STATE OF KANSAS, COUNTY OF MCPHERSON, ss.

(employee of owner) or (owner or operator) of the above-described well, being first duly sworn on oath, says: That I have knowledge of the facts, statements, and matters herein contained and the log of the above-described well as filed and that the same are true and correct. So help me God.

(Signature) Frank J. Black

(Address)

SUBSCRIBED AND SWORN TO before me this 29 day of July, 19 58

My commission expires Jan 10 19 61

RECEIVED Notary Public.
STATE CORPORATION COMMISSION

PLUGGING
FILE SEC 31 T 21 R 11 W
BOOK PAGE 114 LINE 30

JUL 31 1958
CONSERVATION DIVISION
Wichita, Kansas

KANSAS WELL LOG BUREAU--KANSAS GEOLOGICAL SOCIETY

508 EAST MURDOCK - WICHITA, KANSAS

COMPANY J. D. FERRELL DRILLING CO., INC.

SEC. 31 T. 21 R. 11W

FARM Fred H. Mellies NO. 1

LOC. NE NE NW

TOTAL DEPTH 3526

COUNTY Stafford

COMM. 1-19-51


COMP. 1-29-51

SHOT OR TREATED

CONTRACTOR J. D. Ferrell Drlg. Co., Inc.

ISSUED 5-12-51

KANSAS

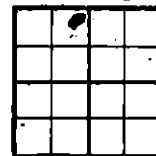

CASING

8 5/8" 218' cem. w/150 sx

5 1/2" 3523' cem. w/75 sx

ELEVATION 1771 D.F.

PRODUCTION I.P.P. 268 BO
& trace water

FIGURES INDICATE BOTTOM OF FORMATIONS

cellar	4
surface sand	110
red bed & shale	219
red bed & shells	510
shale & red bed	1030
shale & salt	1320
lime & shale	2170
broken lime	2355
shale & shells	2535
lime & shale	2655
broken lime	2975
sandy lime	3005
lime	3080
shale	3163
lime	3485
lime, chert, sand	3523
arbuckle	3526 RTD
Total Depth	

Tops: K.B. measurements

Lansing-Kansas City	3181
Cherty Congl.	3453
Viola Chert	3466
Simpson Shale	3476
Arbuckle	3523

JUL 10 1953
 CONSERVATION DIVISION
 Wichita, Kansas

PLUGGING

FILE SEC 31 T 21 R 11W
 BOOK PAGE 114 LINE 30