


WELL PLUGGING RECORD

Give All Information Completely Make Required Affidavit Mail or Deliver Report to: Conservation Division State Corporation Commission 212 No. Market Wichita, Kansas

NORTH

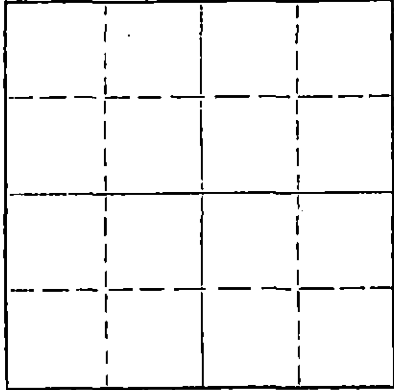

Locate well correctly on above Section Plat

Rush County, Sec. 23 Twp. 18 Rge. 16 (E)W (W) Location as "NE/CNW/SW" or footage from lines NE NE SW Lease Owner Independent Lease Management Company Lease Name Koriel "B" Well No. 4 Office Address Wichita, Kansas Character of Well (completed as Oil, Gas or Dry Hole) Date well completed 19 Application for plugging filed 19 Application for plugging approved 19 Plugging commenced 10-15-66 19 Plugging completed 10-26-66 19 Reason for abandonment of well or producing formation Depleted

If a producing well is abandoned, date of last production 19 Was permission obtained from the Conservation Division or its agents before plugging was commenced? yes

Name of Conservation Agent who supervised plugging of this well Leo Massey Producing formation Depth to top Bottom Total Depth of Well 3499 Feet Show depth and thickness of all water, oil and gas formations.

OIL, GAS OR WATER RECORDS

CASING RECORD

Table with 7 columns: FORMATION, CONTENT, FROM, TO, SIZE, PUT IN, PULLED OUT. Contains data for 15", 10", and 7" casing sizes.

Describe in detail the manner in which the well was plugged, indicating where the mud fluid was placed and the method or methods used in introducing it into the hole. If cement or other plugs were used, state the character of same and depth placed, from feet to feet for each plug set.

Checked hole to 3499', sanded hole to 3460' and dumped 7 sacks of cement @ 3460' with dump bailer. Pulled 7" casing, set 10' rock bridge @ 300' and pumped 40 sacks of gel mud and 150 sacks of cement to cap well.

RECEIVED STATE CORPORATION COMMISSION 11-15-1966 NOV 15 1966

PLUGGING COMPLETE.

CONSERVATION DIVISION Wichita, Kansas

Name of Plugging Contractor KNIGHT CASING PULLING COMPANY Address CHASE, KANSAS

STATE OF KANSAS COUNTY OF RICE, ss.

Noel J. Knight (employee of owner) or (owner/representative) of the above-described well, being first duly sworn on oath, says: That I have knowledge of the facts, statements, and matters herein contained and the log of the above-described well as filed and that the same are true and correct. So help me God.

(Signature) Noel J. Knight Chase, Kansas (Address)

SUBSCRIBED AND SWORN TO before me this 28th day of October, 1966

My commission expires May 20, 1968

Milton J. Volin Notary Public.

Well log of Koriel #4B

NE NE SW

Spudded: July 18, 1937  
 Set casing: July 23, 1937  
 Completed: August 15, 1937

Loc: 23-18S-16W  
 Rush County, Kansas  
 Flynn Oil Company

Total depth ; 3488'

<u>From</u>	<u>To</u>	<u>Formation</u>	<u>Remarks</u>
0	12	Cellar	
12	15	Surface soil & sand	
15	95	Shale & shells	
95	200	Shale & shells	
200	397	Shale and red rock	
397	402	Sand	
402	510	Sand	
510	605	Shale and sand	
605	650	stioy shale	
650	745	Red rock and shale	
745	905	Red rock and shale	
905	974	Red rock and shale	
974	979	Anhydrite	
979	983	Anhydrite	
983	1005	Anhydrite	
1005	1185	Red rock and shale and shells	
1185	1425	Shale and shells	
1425	1460	Salt	
1460	1560	Salt	
1560	1680	Shale and shells	
1680	1705	Broken lime	
1705	1770	Broken lime	
1770	1815	Lime	
1815	1730	Lime	
1830	1940	Broken lime	
1940	2060	Broken lime	
2060	2110	Lime	
2110	2175	Lime	
2175	2250	Broken lime	
2250	2350	Broken lime	
2350	2450	Broken lime	
2450	2510	Broken lime	
2510	2595	Broken lime	
2595	2625	Shale & shells	
2625	2660	Shale & shells	
2660	2705	Shale & shells	
2705	2745	Lime	
2745	2815	Lime	
2815	2840	Lime	
2840	2910	Broken lime	
2910	2950	Broken lime	
2950	2980	Lime	
2980	3045	Lime	
3045	3090	Lime	
3090	3095	Lime	
3095	3145	Sandy shale and shells	
3145	3150	Lime	
3150	3175	Lime	
3175	3245	Broken lime	
3245	3285	Broken lime	
3285	3325	Lime	
3325	3350	Lime	
3350	3390	Lime	
3390	3425	Lime	
3425	3455	Lime	
3455	3475	Lime	
3475	3480	Broken lime	
3480	3487	Conglomerate & lime & show of oil	
3487	3498	Lime	
3498	3555	Sand	
3498	3535	Gas - - Estimate 40 million	
3498	3509	Oil show	
3433	3435	Oil - - Estimate 200 barrels	
3444	3450	Increase oil	

RECEIVED  
 CORPORATION COMMISSION  
 OCT 21 1966  
 CONSERVATION DIVISION  
 WICHITA, KANSAS

#4