

RECEIVED
STATE CORPORATION COMMISSION

APR 30 1974


CONSERVATION DIVISION
Wichita, Kansas

STATE OF KANSAS
STATE CORPORATION COMMISSION

15.165.02141.00.00

WELL PLUGGING RECORD

Give All Information Completely
State Required Affidavit
Must be Delivered Report to
Conservation Division
State Corporation Commission
P. O. Box 17027
Wichita, Kansas 67217

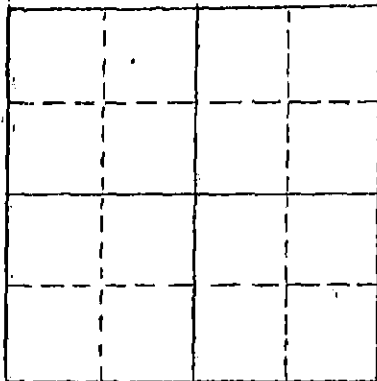

Locate well correctly on above
Section Plat

Rush County, Sec. 23 Twp. 18 Rge. 16 (E) (W) &
Location as "NE/CNW/SE/SW" or footage from lines SW - NW SE NW
Lease Owner: Twin Western Resources, Inc.
Lease Name: Kariel Well No. A-5
Office Address: 200 E. First St. Suite 518 Wichita, Kansas 67202
Character of Well (completed as Oil, Gas or Dry Hole) _____
Date well completed _____ 19____
Application for plugging filed _____ 19____
Application for plugging approved _____ 19____
Plugging commenced 4-22-74 _____ 19____
Plugging completed 4-26-74 _____ 19____
Reason for abandonment of well or producing formation _____

If a producing well is abandoned, date of last production _____ 19____
Was permission obtained from the Conservation Division or its agents before plugging was commenced? _____

Name of Conservation Agent who supervised plugging of this well Leo Massey
Producing formation _____ Depth to top _____ Bottom _____ Total Depth of Well 3556 1/2 Feet
Show depth and thickness of all water, oil and gas formations.

OIL, GAS OR WATER RECORDS

CASING RECORD

FORMATION	CONTENT	FROM	TO	SIZE	PUT IN	PULLED OUT
				7"	3531'	1395 50'
				10 3/4"	995'	
				15 1/2"	144'	

Describe in detail the manner in which the well was plugged, indicating where the mud fluid was placed and the method or methods used in introducing it into the hole. If cement or other plugs were used, state the character of same and depth placed, from _____ feet to _____ feet for each plug set.

Made bottom hole plug back with sand to 3500'. Mixed and ran 6 sacks cement thru dump bailer.
Mudded hole to 350' set 25' rock bridge.
Filled hole with 6 yards ready-mix to base of cellar.

(If additional description is necessary, use BACK of this sheet)


Name of Plugging Contractor: Southwest Casing Pulling Co.
Address: Box 364 Great Bend, Kansas

STATE OF Kansas COUNTY OF Barton ss.

Southwest Casing Pulling Co. (employee of owner) or (owner or operator) of the above-described well, being first duly sworn on oath, says: That I have knowledge of the facts, statements, and matters herein contained and the log of the above-described well as filed and that the same are true and correct. So help me God.

(Signature) W. C. Spencer Sec.
Box 364 Great Bend, Kansas 67530 (Address)

Subscribed and sworn to before me this 29 day of April 19 74

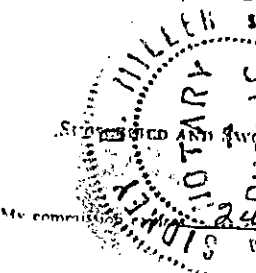

Sidney D. Miller Notary Public.

FIELD OIL COMPANY
Kortel No. 5

SEC. 23 T. 18 R. 16 W.
S.W. 1/4

Total Depth: 3556 1/2
Comm. 9-19-61 Comp. 10-16-61
Shot or treated.
Contractor: J.A. Aylward
Issued: 11-12-64

Company: Aylward

CASING

Rating

15" 144' Con. - 110' depth
10" 295' Con. - 385' depth
7" 351' Con.

Elevation:

Production: Nov. 1972

Figures indicate Bottom of Formations.

shale and sand	60
shale and red rock	185
shale and shells	385
shale	405
sand	535
red rock and sand	620
red rock	655
red rock and sand	965
red rock	983
anhydrite	990
lime	1009
red rock	1019
red rock and shale	1355
shale	1450
salt and shale	1670
lime and shale	1726
lime and shale brks	1860
lime and shale	1970
lime and shale	2075
lime	2165
lime and shale	2240
shale	2290
lime and shale	2590
shale and shells	2605
lime	2720
broken lime	2805
shale lime	2825
shale sticky	2840
lime broken	2855
lime	3025
lime hard	3065
broken lime	3160
lime	3220
shale	3230
lime	3360
lime hard	3400
sdv lime	3420
lime	3465
lime and shale	3510
sand hard	3520
sand	3556 1/2

Total Depth oil sand 3524-3556 1/2

RECEIVED
STATE CORPORATION COMMISSION
NOV 17 1970
CONSERVATION DIVISION
Wichita, Kansas