

STATE OF KANSAS
STATE CORPORATION COMMISSION

Form CP-4

WELL PLUGGING RECORD

Give All Information Completely
Make Required Affidavit
Mail or Deliver Report to:
Conservation Division
State Corporation Commission
212 No. Market
Wichita, Kansas

Rush County. Sec. 23 Twp. 18 Rge. 16 (E) W (W)

Location as "NE/CNW%SW%" or footage from lines C EL NW/4

Lease Owner Independent Lease Management Company

Lease Name Koriel "A" Well No. 6

Office Address Wichita, Kansas

Character of Well (completed as Oil, Gas or Dry Hole)

Date well completed 19

Application for plugging filed 19

Application for plugging approved 19


Plugging commenced 9-19-66 19

Plugging completed 9-21-66 19

Reason for abandonment of well or producing formation - Depleted.

If a producing well is abandoned, date of last production' 19

Was permission obtained from the Conservation Division or its agents before plugging was commenced? yes

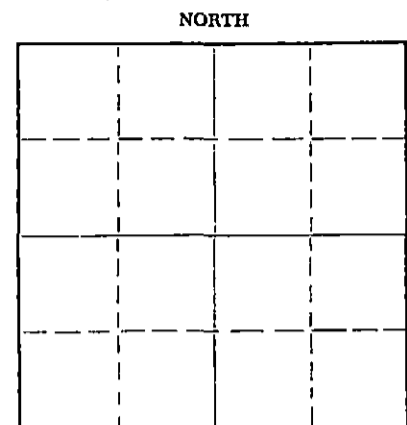

Locate well correctly on above Section Plat

Name of Conservation Agent who supervised plugging of this well Leo Massey

Producing formation Depth to top Bottom Total Depth of Well 3570 Feet

Show depth and thickness of all water, oil and gas formations.

OIL, GAS OR WATER RECORDS

CASING RECORD

FORMATION	CONTENT	FROM	TO	SIZE	PUT IN	PULLED OUT
				8-5/8"	975'	None
				5-1/2"	3570'	1815'

Describe in detail the manner in which the well was plugged, indicating where the mud fluid was placed and the method or methods used in introducing it into the hole. If cement or other plugs were used, state the character of same and depth placed, from feet to feet for each plug set.

Checked hole to 3550', sanded hole to 3500' and dumped 5 sacks of cement @ 3500' with dump bailer. Pulled 5 1/2 casing, set 20' rock bridge @ 450' and filled hole with 6 yards of ready-mix cement.

FILED
STATE CORPORATION COMMISSION
OCT 4 1966
CONSERVATION DIVISION
Wichita, Kansas
10-4-66

PLUGGING COMPLETE.

Name of Plugging Contractor KNIGHT CASING PULLING COMPANY
Address CHASE, KANSAS

STATE OF KANSAS, COUNTY OF RICE, ss.

Noel J. Knight (employee of owner) or (owner/operated) of the above-described well, being first duly sworn on oath, says: That I have knowledge of the facts, statements, and matters herein contained and the log of the above-described well as filed and that the same are true and correct. So help me God.

(Signature) Noel J. Knight
Chase, Kansas
(Address)

SUBSCRIBED AND SWORN TO before me this 27th day of September, 1966

My commission expires May 20, 1968

Milton J. Volin
Notary Public.

BRUNSON-SPINER, INC.
302 Union Center
Wichita 2, Kansas

WELL: Koriol "A" 66 C 21 SW/4
COMMENCED NO: 7-9-60 23-168-16W
COMPLETED NO: 7-22-60
TOTAL DEPTH: 3570'
RUSH COUNTY, KANSAS
ELEVATION: 1930' (Estimate)
CASING: 975' 8 5/8" surface
3570' 5 1/2" drill string CONTRACTOR: Brunson-Spiner, Inc.

STRATA	DEPTH	TOPS	
Gravel	45	Lansing - Kansas City	3215'
Sand and Clay	49	Keagan Sand	3477'
Shale and Shells	103	Pre-Cambrian	3543
Red Bed	335		
Hard Sand & Pyrite	340		
Sand and Pyrite	370		
Sand and Shale	415		
Sand	505		
Shale and Sand	640		
Sand	590		
Shale and Shells	700		
Shale	695		
Red Bed	960		
Anhydrite	1,010		
Red Bed	1,040		
Shale and Salt	1,400		
Shale and Shells	1,620		
Lime	2,380		
Shale and Lime	2,925		
Lime	3,457		
Sand	3,570 TD		

3543
1930
1547
1930
1613

RECEIVED
STATE CORPORATION COMMISSION
AUG 18 1966
REGISTRATION DIVISION
Wichita, Kansas

I hereby certify that the above is a true and correct log of said well as reflected on the daily drilling report.

Ralph B. McLaughlin
Ralph B. McLaughlin, Secretary-Treasurer

Subscribed and sworn to in my presence this 5th day of August, 1960, by Ralph B. McLaughlin, of Brunson-Spiner, Inc.

Fay L. Jefferson
Fay L. Jefferson, Notary Public.