


STATE OF KANSAS
STATE CORPORATION COMMISSION

Give All Information Completely
Make Required Affidavit
Mail or Deliver Report to
Conservation Division
State Corporation Commission
245 North Water
Wichita, KS 67202

FORM CP-4

WELL PLUGGING RECORD

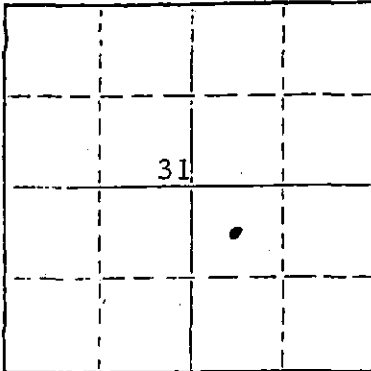

Locate well correctly on above Section Plot

Rush County, Sec. 31, T₁₉S, R₁₉E, (E) 20 (W)
Location as "NE/CNWKSWH" or footage from lines: NW, NW of SE/4
Lease Owner: Mesa Petroleum Co., 2310' FSL & FEL
Lease Name: McJunkin Well No. #31-10
Office Address: P. O. Box 2009, Amarillo, Texas 79105
Character of Well (completed as Oil, Gas or Dry Hole): Oil Well
Date well completed: 12/9/65 19
Application for plugging filed: November 15, 1977 19
Application for plugging approved: November 21, 1977 19
Plugging commenced: December 2, 1977 19
Plugging completed: December 2, 1977 19
Reason for abandonment of well or producing formation: depleted - dry
If a producing well is abandoned, date of last production: 3/4/77 19
Was permission obtained from the Conservation Division or its agents before plugging was commenced? Yes

Name of Conservation Agent who supervised plugging of this well: Leo F. Massey
Producing formation: Mississippian Depth to top: 4392' Bottom: 4408' Total Depth of Well: 4475 Feet
Show depth and thickness of all water, oil and gas formations.

OIL, GAS OR WATER RECORDS

CASING RECORD

FORMATION	CONTENT	FROM	TO	SIZE	PUT IN	PULLED OUT
				4 1/2"	4474'	None
				8 5/8"	353'	None

Describe in detail the manner in which the well was plugged, indicating where the mud fluid was placed and the method or methods used in introducing it into the hole. If cement or other plugs were used, state the character of same and depth placed, from _____ feet to _____ feet for each plug set.

Spotted 25 sacks cement to 4000' through tubing, pulled tubing to 600',
spotted 75 sacks cement to surface, laid down tubing, pressured up on
casing to 900 lbs.

RECEIVED
STATE CORPORATION COMMISSION

DEC 19 1977

Name of Plugging Contractor: Lillard & Wilson, Inc. (If additional description is necessary, use BACK of this sheet)
Address: P. O. Box 962 Woodward, Oklahoma 73801
Wichita, Kansas

STATE OF Texas COUNTY OF Potter ss.

Mesa Petroleum Co. (employee of owner) or (owner or operator) of the above-described well, being first duly sworn on oath, says: That I have knowledge of the facts, statements, and matters herein contained and the log of the above-described well as filed and that the same are true and correct. So help me God.

(Signature) George Wilson
P. O. Box 2009, Amarillo, Tx. 79105
(Address)

SUBSCRIBED AND SWORN TO before me this 16th day of December, 1977

My commission expires 2/28/78
Notary Public.