

STATE OF KANSAS
STATE CORPORATION COMMISSION


WELL PLUGGING RECORD

Give All Information Completely
Make Required Affidavit
Mail or Deliver Report to:
Conservation Division
State Corporation Commission
211 No. Broadway
Wichita, Kansas

Rush County, Sec. 31 Twp. 19S Rge. (E) 20 (W)

Location as "NE/CNWSW" or footage from lines C SW NE
Lease Owner Pubco Petroleum Corporation
Lease Name Hamzy Well No. 31-7
Office Address P.O. Box 432, McCook, Nebraska
Character of Well (completed as Oil, Gas or Dry Hole) Dry Hole
Date well completed July 21 19 65
Application for plugging filed July 22 19 65
Application for plugging approved July 26 19 65
Plugging commenced July 21 19 65
Plugging completed July 21 19 65
Reason for abandonment of well or producing formation Non-productive

NORTH

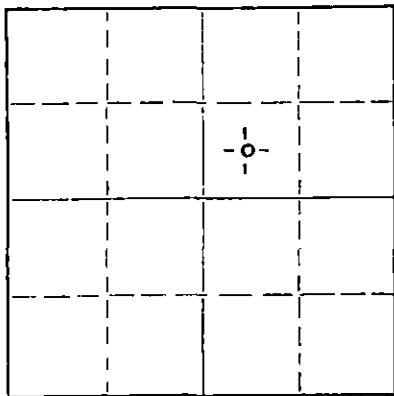

Locate well correctly on above
Section Plat

If a producing well is abandoned, date of last production 19
Was permission obtained from the Conservation Division or its agents before plugging was commenced? Yes

Name of Conservation Agent who supervised plugging of this well Gilbert Leiker
Producing formation Depth to top Bottom Total Depth of Well 4480 Feet
Show depth and thickness of all water, oil and gas formations.

OIL, GAS OR WATER RECORDS

CASING RECORD

FORMATION	CONTENT	FROM	TO	SIZE	PUT IN	PULLED OUT
				8 5/8" 28#	514'	None

Describe in detail the manner in which the well was plugged, indicating where the mud fluid was placed and the method or methods used in introducing it into the hole. If cement or other plugs were used, state the character of same and depth placed, from feet to feet for each plug set.

Drilling mud from	500'	to	4480'
20 sack cement plug from	430'	to	500'
Drilling mud from	220'	to	430'
20 sack cement plug from	150'	to	220'
Drilling mud from	40'	to	150'
10 sack cement plug from	5'	to	40'

RECEIVED
STATE CORPORATION COMMISSION

AUG 18 1965

8-18-65
CONSERVATION DIVISION
Wichita, Kansas

Well plugged through drill pipe.

(If additional description is necessary, use BACK of this sheet)

Name of Plugging Contractor Murfin Drilling Company
Address 617 Union Center Building, Wichita, Kansas

STATE OF Nebraska, COUNTY OF Red Willow, ss.
I, Michael E. Carr (employee of owner) or (owner or operator) of the above-described well, being first duly sworn on oath, says: That I have knowledge of the facts, statements, and matters herein contained and the log of the above-described well as filed and that the same are true and correct. So help me God.

(Signature) Michael E. Carr
P.O. Box 432, McCook, Nebraska
(Address)

SUBSCRIBED AND SWORN TO before me this 16th day of August, 19 65

Annafel Kugler
Notary Public.

My commission expires June 29, 1971

15.165.30031.00.00

W E L L L O G

COMPANY: Pubco Petroleum Corporation

CONTRACTOR: Murfin Drilling Company

FARM: Hamzy 31-7

LOCATION: C SW NE, Sec. 31-19S-20W, Rush County, Kansas

COMMENCED: July 9, 1965 ELEVATION: 2287' G.L.
2292' K.B.

COMPLETED: July 21, 1965 POTENTIAL: D.& A.

SURFACE CASING: Set 8 5/8" 28# used casing at 514' cemented with 275 sacks of 50:50 Pozmix A with 3% HA-5. Cement circulated.

PLUGGING RECORD: Spotted 20 sack plug at 500', 20 sack plug at 220' and 10 sack plug at 40'. Completed plugging at 9:00 p.m. 7-21-65.

DRILLERS LOG:

0	to	270	Clay & Shale
270	to	517	Shale & Shells
517	to	1486	Shale & Red Bed
1486	to	1524	Anhydrite
1524	to	2390	Shale
2390	to	2955	Lime
2955	to	3310	Lime & Shale
3310	to	3480	Shale & Lime
3480	to	3837	Lime & Shale
3837	to	4390	Lime
4390	to	4407	Lime & Chert
4407	to	4419	Lime & Chert
4419	to	4432	Sand, Shale & Chert
4432	to	4450	Lime & Chert
4450	to	4452	Lime & Chert
4452	to	4461	Lime & Shale
4461	to	4480	Chert & Lime
			Rotary Total Depth

SCHLUMBERGER ELECTRIC LOG TOPS:

Heebner	3794	-1502
Lansing	3842	-1550
Base Kansas City	4174	-1882
Ft. Scott	4324	-2032
Cherokee	4338	-2046
Mississippian	4390	-2098
Schlumberger T.D.	4478	-2186

RECEIVED
STATE CORPORATION COMMISSION

AUG 18 1965

CONSERVATION DIVISION
Wichita, Kansas
