


Give All Information Completely  
Make Required Affidavit  
Mail or Deliver Report to:  
Conservation Division  
State Corporation Commission  
800 Bitting Building  
Wichita, Kansas

WELL PLUGGING RECORD

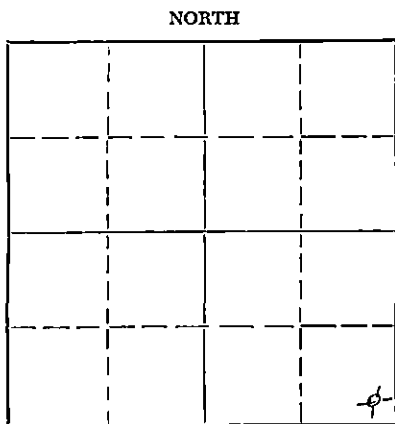

Locate well correctly on above  
Section Plat

Rush County. Sec. 12 Twp. 19 Rge. 20 (E) (W)  
Location as "NE/CNW%SW%" or footage from lines SE SE SE/4  
Lease Owner S. A. Murphy  
Lease Name L. E. Murphy Well No. 1  
Office Address 701 Brown Bldg. Wichita 2, Kansas  
Character of Well (completed as Oil, Gas or Dry Hole) Dry hole  
Date well completed 10-15-54 19  
Application for plugging filed " 19  
Application for plugging approved " 19  
Plugging commenced " 19  
Plugging completed " 19  
Reason for abandonment of well or producing formation \_\_\_\_\_

If a producing well is abandoned, date of last production \_\_\_\_\_ 19  
Was permission obtained from the Conservation Division or its agents before plugging was commenced? yes

Name of Conservation Agent who supervised plugging of this well Warren H. Horner  
Producing formation \_\_\_\_\_ Depth to top \_\_\_\_\_ Bottom \_\_\_\_\_ Total Depth of Well 4475 Feet  
Show depth and thickness of all water, oil and gas formations.

OIL, GAS OR WATER RECORDS

CASING RECORD

FORMATION	CONTENT	FROM	TO	SIZE	PUT IN	PULLED OUT
		0	257	Ø 5/8"	261.53	none

Describe in detail the manner in which the well was plugged, indicating where the mud fluid was placed and the method or methods used in introducing it into the hole. If cement or other plugs were used, state the character of same and depth placed, from \_\_\_\_\_ feet to \_\_\_\_\_ feet for each plug set.

Mudded hole to 250 ft. - 1/3 sx hulls & 20 sx cement

Mudded hole to 35 ft. - 1/3 sx hulls and 10 sx cement.

(If additional description is necessary, use BACK of this sheet)


Name of Plugging Contractor Virginia Drilling Co Inc.  
Address 701 Brown Bldg. Wichita, Kansas

STATE OF Kansas, COUNTY OF Sedgwick, ss.  
S. A. Murphy (employee of owner) or (owner or operator) of the above-described well, being first duly sworn on oath, says: That I have knowledge of the facts, statements, and matters herein contained and the log of the above-described well as filed and that the same are true and correct. So help me God.

(Signature) [Signature]  
701 Brown Bldg., Wichita 2, Kansas  
(Address)

SUBSCRIBED AND SWORN TO before me this 29th day of October, 19 54  
[Signature] Notary Public.

My commission expires February 5, 1957.

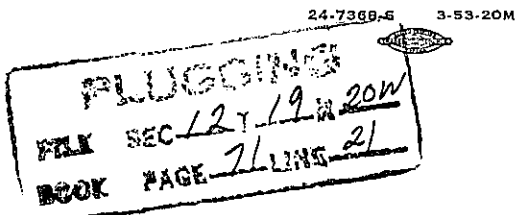

Well: L. E. Murphy # 1  
 Location: SE SE SE Section 12-19s-20w, Rush County, Kansas  
 Company: S. A. Murphy  
 Contractor: Virginia Drilling Co., Inc.  
 Commenced: September 28, 1954  
 Completed: October 15, 1954  
 Elevation: 2147 D. F.  
 Total Depth: 4475

FORMATION	DEPTH	
Soil-post rock	0-90	
Shale-lime-shells	90-125	
Shale-shell	125-210	
Sand	210-225	
Shale-shell	225-280	Set 261' of 8-5/8" csg.
Shale	280-375	
Sand	375-450	
Shale-shells	450-725	
Sand-shale	725-1150	
Red Bed-shale	1150-1367	
Anhydrite	1367-1410	TOPS:
Shale-shells	1410-1700	Heebner Shale 3668
Shale-shells-salt	1700-1935	Toronto Lime 3688
Shale-shells	1935-2170	Lansing 3716
Lime-shale	2170-2350	Base Kansas City 4040
Lime broken	2350-2425	Marmaton 4058
Shale-lime	2425-2580	Conglomerate (shale) 4144
Lime	2580-2710	Conglomerate (Cherty) 4198
Lime-shale	2710-2825	Mississippi Lime 4272
Lime-shale-sand strks	2825-2955	Mississippi (Dolomitic Lime) 4398
Lime-shale	2955-3565	Kinderhook Shale 4434
Lime	3565-4161	Viola Lime (dolomitic) 4448
Sand	4161-4168	
Lime-shale	4168-4185	
Lime-sandy cong.	4185-4220	
Lime-sand-chert	4220-4240	
Lime-chert-shale	4240-4280	
Cherty lime	4280-4330	
Viola Lime-chert	4330-4355	
Cherty Lime	4355-4384	
Lime	4384-4440	
Cherty Lime	4440-4475	

Now comes S. A. Murphy, who states that he is familiar with the drilling of oil and gas wells and knows of his own knowledge that the L. E. Murphy #1, located SE SE SE Section 12-19s-20w, Rush County, Kansas, was drilled to a total depth of 4475 feet. Same was plugged and abandoned.

S. A. Murphy

Subscribed and sworn to before me this 28th day of October, 1954.

Inez M. Underwood

My commission expires March 15, 1958.

