

STATE OF KANSAS  
STATE CORPORATION COMMISSION

Form CP-4

WELL PLUGGING RECORD

Give All Information Completely  
Make Required Affidavit  
Mail or Deliver Report to:  
Conservation Division  
State Corporation Commission  
211 No. Broadway  
Wichita, Kansas

Rush County, Sec. 9 Twp. 19 Rge. 20 (E) W (W)

Location as "NE/CNW/SW" or footage from lines SW/4 SE/4 SE/4

Lease Owner Shields Oil Producers, Inc.

Lease Name ADA YOUNG "C" Well No. 1

Office Address Shields Building, Russell, Kansas

Character of Well (completed as Oil, Gas or Dry Hole) Oil Well

Date well completed April 15 19 55

Application for plugging filed March 16 19 64

Application for plugging approved March 17 19 64


Plugging commenced April 13 19 64

Plugging completed April 16 19 64

Reason for abandonment of well or producing formation Depleted Well

If a producing well is abandoned, date of last production May 1 19 64

Was permission obtained from the Conservation Division or its agents before plugging was commenced? Yes

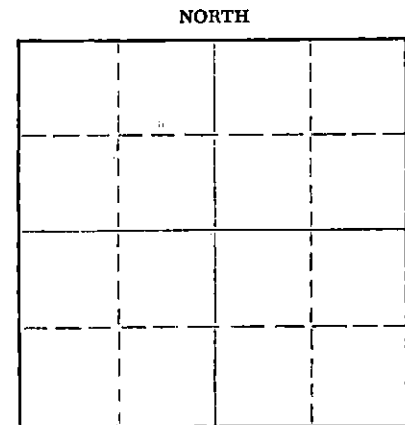

Name of Conservation Agent who supervised plugging of this well Petty

Producing formation \_\_\_\_\_ Depth to top \_\_\_\_\_ Bottom \_\_\_\_\_ Total Depth of Well 4310 Feet

Show depth and thickness of all water, oil and gas formations.

OIL, GAS OR WATER RECORDS

CASING RECORD

FORMATION	CONTENT	FROM	TO	SIZE	PUT IN	PULLED OUT
				8 5/8"	190'	Cmtd.
				5 1/2"	4,309'	3,548'

Describe in detail the manner in which the well was plugged, indicating where the mud fluid was placed and the method or methods used in introducing it into the hole. If cement or other plugs were used, state the character of same and depth placed, from 4310 feet to surface feet for each plug set.

Sanded up to 4200'. Dumped 5 sacks of cement on bottom.

Pulled pipe up to 550'. Circulated with mud. Pumped 20

sacks of cement to 470'. Pulled pipe up to 175'. Pumped

20 sacks of cement to 175'. Pulled pipe out and put 10

sacks of cement on top.

Well Completed.

RECEIVED  
STATE CORPORATION COMMISSION

MAY 4 1964  
5-4-64  
CONSERVATION DIVISION  
Wichita, Kansas

(If additional description is necessary, use BACK of this sheet)

Name of Plugging Contractor Barnes and Sons Pipe Pulling Company

Address P.O. Box 313 Russell, Kansas

STATE OF Kansas, COUNTY OF Russell, ss.

Robert J. Shields (employee of owner) or (owner or operator) of the above-described well, being first duly sworn on oath, says: That I have knowledge of the facts, statements, and matters herein contained and the log of the above-described well as filed and that the same are true and correct. So help me God.

(Signature) Robert J. Shields

Shields Building, Russell, Kansas

(Address)

SUBSCRIBED AND SWORN TO before me this 1st day of May, 19 64

My commission expires

January 31, 1968

Agnes M. Appel

Notary Public.


STENCILED

WELL LOG BUREAU—KANSAS GEOLOGICAL SOCIETY ORIGINAL  
 508 East Murdock, Wichita, Kansas

MAY 7 1955  
 Company- REPUBLIC NATURAL GAS CO.  
 Farm- R.L. Young "C" No. 1

SEC. 9 T. 19 R. 20W  
 SW SE SE

Total Depth. 4310'  
 Comm. 2-1-55 Comp. 2-16-55  
 Shot or Treated.  
 Contractor. Drlg. Dept. of Natural Gas & Oil Co.  
 Issued. 5-7-55

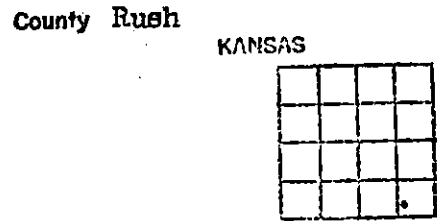

CASING:  
 8 5/8" 190' w/175 sx c em.  
 5 1/2" 4306' w/50 sx c em.

Elevation. 2196 GL

Production. 29 bbls.

Figures indicate Bottom of Formations.

clay-shale	50
shale-shells	415
sand	475
shale-shells	840
sand	1090
shale-shells	1417
Anhydrite	1448 +
shale-shells	1840
shale-lime	3500
lime	4222
Coring	4240
Conglomerate	4268
shale-lime	4302
lime	4310
Total Depth	

TOPs: Scout	
Anhydrite	1417
Heebner	3697
Lansing	3741
Cherokee	4220
Mississippi	4281

DST #1 - 4212-22, open 1 hr.,  
 rec. 3368' oil & 60' watery  
 cu t mud, SI 1/2 hr., IFP 505#,  
 FFP 1325# & BHP 1355# in 30  
 min.

DST #2 - 4224-32, open 1 hr.,  
 Gas in 15 min., rec. 2914'  
 salt wtr., IFP 400 #, FFP 700#,  
 BHP 730#, in 30 min.

Ran Schlumberger.

RECEIVED  
 STATE CORPORATION COMMISSION

JUL 16 1964

CONSERVATION DIVISION  
 Wichita, Kansas