


Give All Information Completely
Make Required Affidavit
Mail or Deliver Report to:
Conservation Division
State Corporation Commission
211 No. Broadway
Wichita, Kansas

WELL PLUGGING RECORD

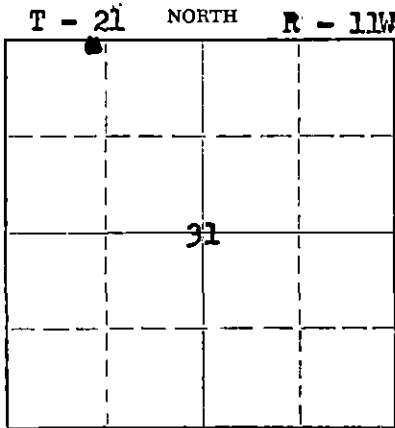

Locate well correctly on above Section Plat

Stafford County, Sec. 31 Twp. 21 Rge. 11 (E) 11 (W)
Location as "NE/CNW/SW" or footage from lines NE - NW - NW
Lease Owner Frank J. Black
Lease Name Mellies Well No. 2
Office Address McPherson, Kansas
Character of Well (completed as Oil, Gas or Dry Hole) Oil
Date well completed Apr. 4 19 51
Application for plugging filed July 9 19 58
Application for plugging approved July 11 19 58
Plugging commenced July 10 19 58
Plugging completed July 16 19 58
Reason for abandonment of well or producing formation Unprofitable

If a producing well is abandoned, date of last production _____ 19____
Was permission obtained from the Conservation Division or its agents before plugging was commenced? Yes

Name of Conservation Agent who supervised plugging of this well Frank Brodfoot
Producing formation _____ Depth to top _____ Bottom _____ Total Depth of Well 3554 Feet
Show depth and thickness of all water, oil and gas formations.

OIL, GAS OR WATER RECORDS

CASING RECORD

FORMATION	CONTENT	FROM	TO	SIZE	PUT IN	PULLED OUT
				8 5/8	222	None
				5 1/2	3515	2767.06

Describe in detail the manner in which the well was plugged, indicating where the mud fluid was placed and the method or methods used in introducing it into the hole. If cement or other plugs were used, state the character of same and depth placed, from _____ feet to _____ feet for each plug set.

Dumped sand to 3500' - dumped 5 sks cement - bailed oil off - mudded to 220' - set 10' rock bridge - dumped 20 sks cement - mudded hole to 40' - set 10' rock bridge - dumped 10 sks cement.

(If additional description is necessary, use BACK of this sheet)

Name of Plugging Contractor R & D Casing Pulling Company License # 236
Address Box 569 Ellinwood, Kansas

STATE OF KANSAS, COUNTY OF MCPHERSON, ss.

(employee of owner) or (owner or operator) of the above-described well, being first duly sworn on oath, says: That I have knowledge of the facts, statements, and matters herein contained and the log of the above-described well as filed and that the same are true and correct. So help me God.

(Signature) Frank J. Black

SUBSCRIBED AND SWORN TO before me this 29 day of July, 19 58

My commission expires Jan 10, 1961
Laust Nelson
Notary Public.

RECEIVED
STATE CORPORATION COMMISSION

JUL 31 1958
PLUGGING
FILE SEC 31 T 21 R 11W
BOOK 114 PAGE 114 LINE 29
Wichita

4-31-1958

WELL LOG BUREAU - KANSAS GEOLOGICAL SOCIETY

508 E. Murdock,

Wichita, Kansas

Company - J. D. WARELL DRILG. CO.
 Farm - F. H. Hollies No. 2

SEC. 31 T. 21 R. 11W
 NE 1/4 NW

Total Depth. 3554 P.B. 3523
 Comm. 3-22-51 Date 4-3-51
 Shot or Treated.
 Contractor. J. D. Ferrell Drilg.
 issued. 7-7-51

County. Stafford
 KANSAS



CASING:
 8 5/8" 222' cem. w/175 sx. circ.
 5 7/8" 3515 cem. w/100 sx.

Elevation. 1781 K.B.

Production. 34 bbls. / 5% wcr.

Figures indicate Bottom of Formations.

sand	95
red bed & shells	535
anhyd.	560
red bed	1005
salt & shells	1260
salt & shells	1765
lime	1880
shale & shells	2970
lime	3070
shale & lime	3375
lime	3388
lime & shale	3455
lime	3465
congl. & chert	3490
cong. & sand	3514
Arb.	3517 RTD
Arb.	3554
Total Depth P.B.	3523

Tops:	
Anhyd.	535
Lansing, K.C.	3182
Congl.	3448
Simpson	3463
Arb.	3514

RECEIVED
 STATE COMMISSION

JUL 10 1958
 CONSERVATION DIVISION
 Wichita, Kansas

PLUGGING
 FILE SEC 31 T 21 R 11W
 BOOK PAGE 114 LINE 29