

STATE OF KANSAS
STATE CORPORATION COMMISSION

WELL PLUGGING RECORD

Give All Information Completely
Make Required Affidavit
Mail or Deliver Report to:
Conservation Division
State Corporation Commission
800 Blitting Building
Wichita, Kansas


OR

FORMATION PLUGGING RECORD

Strike out upper line
when reporting plug-
ging of formations.

Rice County. Sec. 15 Twp. 21 Rge. (E) 7 (W)

Location as "NE 1/4 NW 1/4 SW 1/4" or footage from lines. NW NW NE
Lease Owner. Francis Oil & Gas, Inc.
Lease Name. Hauschild Well No. 1
Office Address. 902 Palace Building
Character of Well (completed as Oil, Gas or Dry Hole)
Date well completed. 19...
Application for plugging filed. 19...
Application for plugging approved. 19...
Plugging commenced. March 21 19 46
Plugging completed. March 30 19 46
Reason for abandonment of well or producing formation.
If a producing well is abandoned, date of last production. 19...
Was permission obtained from the Conservation Division or its agents before plugging was com-
menced?.....

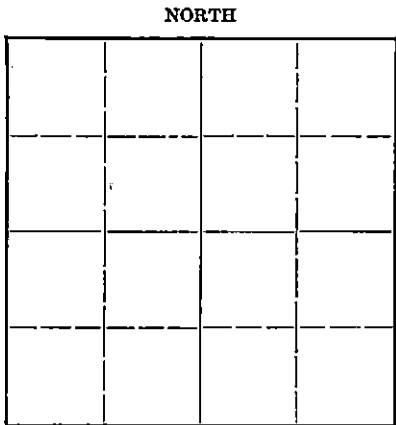

Locate well correctly on above
Section Plat

Name of Conservation Agent who supervised plugging of this well. Mr. Ruel Durkee
Producing formation. Depth to top. Bottom. Total Depth of Well. Feet
Show depth and thickness of all water, oil and gas formations.


OIL, GAS OR WATER RECORDS

CASING RECORD

Formation	Content	From	To	Size	Put In	Pulled Out
Conglomerate				7" O.D.		2377'

Describe in detail the manner in which the well was plugged, indicating where the mud fluid was placed and the method or methods used in introducing it into the hold. If cement or other plugs were used, state the character of same and depth placed, from... feet to ... feet for each plug set.

Dumped 6 sacks of cement in bottom of hole. Shot pipe off at 2300'. Pulled pipe. Mudded hole to 200'. Dumped 25 sacks of cement at 200'. Finished mudding hole. Put 6 sacks of cement in top of surface pipe.

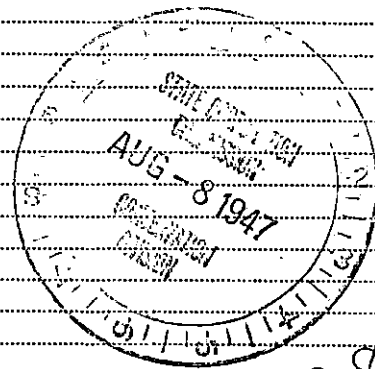

8-8-47

(If additional description is necessary, use BACK of this sheet)

Correspondence regarding this well should be addressed to Francis Oil & Gas, Inc.
Address. 902 Palace Building
Tulsa 3, Oklahoma

STATE OF Oklahoma, COUNTY OF Tulsa, ss.
Meyer C. Miller (employee of owner) or (owner or operator) of the above-described well,
being first duly sworn on oath, says: That I have knowledge of the facts, statements, and matters herein contained and the log of the above-described well as filed and that the same are true and correct. So help me God.

(Signature) Meyer C. Miller
902 Palace Building, Tulsa 3, Oklahoma.
(Address)

SUBSCRIBED AND SWORN to before me this 6 day of August, 19 47

Agred Pittner
Notary Public.

My commission expires November 3, 1950

