

STATE OF KANSAS
STATE CORPORATION COMMISSION

WELL PLUGGING RECORD


Give All Information Completely
Make Required Affidavit
Mail or Deliver Report to
Conservation Division
State Corporation Commission
800 Bitting Building
Wichita, Kansas

OR

FORMATION PLUGGING RECORD

Strike out upper line
when reporting plug-
ging off formations.

Rice County. Sec. 15 Twp. 21 Rge. 7W. ~~6E~~ (W)
Location as "NE 1/4 NW 1/4 SW 1/4" or footage from lines. CEL W/2 SE
Lease Owner. Simon Lebow
Lease Name. G. A. Engelland Well No. 2
Office Address. 807 Palace Bldg. Tulsa, Okla.
Character of Well (completed as Oil, Gas or Dry Hole) oil
Date well completed. July 8, 1939 19. 46
Application for plugging filed. November 18 19. 46
Application for plugging approved. November 26 19. 46
Plugging commenced. December 18 19. 46
Plugging completed. December 23 19. 46
Reason for abandonment of well or producing formation

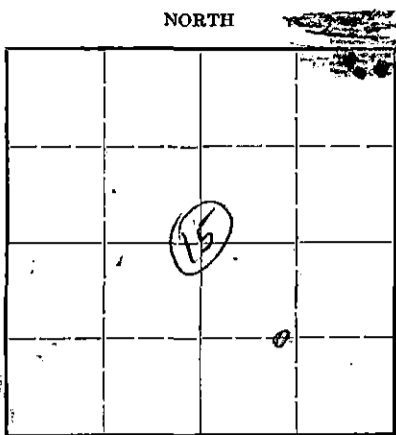

Locate well correctly on above
Section Plat

If a producing well is abandoned, date of last production. September 19. 46
Was permission obtained from the Conservation Division or its agents before plugging was com-
menced? yes

Name of Conservation Agent who supervised plugging of this well.
Producing formation. Chat Depth to top. 3394 Bottom. 3423 Total Depth of Well. 3423 Feet
Show depth and thickness of all water, oil and gas formations.

OIL, GAS OR WATER RECORDS

CASING RECORD

Formation	Content	From	To	Size	Put In	Pulled Cut
shale				4"	103'	
conglomerate				7"	3378'	

Describe in detail the manner in which the well was plugged, indicating where the mud fluid was placed and the method or methods used in introducing it into the hold. If cement or other plugs were used, state the character of same and depth placed, from.....feet to.....feet for each plug set.

Dumped 6 sacks of cement in bottom of hole. Shot pipe off at 2500'. Pulled pipe, mudded hole up to 150'. Put 25 sacks of cement at 150'. Finished mudding surface pipe, and put 8 sacks of cement in top of surface pipe. Supervised by Raul Durkee.

PLUGGING
FILE 15.21.7W
BOOK PAGE 82

1-18-47

(If additional description is necessary, use BACK of this sheet)

Correspondence regarding this well should be addressed to Simon Lebow
Address. 807 Palace Bldg., Tulsa, Okla.

STATE OF Oklahoma, COUNTY OF Tulsa, ss.

Simon Lebow (owner or operator) of the above-described well,
being first duly sworn on oath, says: That I have knowledge of the facts, statements, and matters herein contained and the log of the above-described well as filed and that the same are true and correct. So help me God.

(Signature) Simon Lebow
(Address) 807 Palace Bldg., Tulsa, Okla.

SUBSCRIBED AND SWORN to before me this 17th day of January, 1947.

My commission expires May 19 1948

Notary Public.

MID PLAINS OIL CORP.
G.A. Engelland No. 2

SEC. 15 T. 21 R. 7W.
GEL W $\frac{1}{2}$ SE

Total Depth. 3390
Comm. 6-14-39 Comp. 7-8-39
Shot or Treated.
Contractor. Jock Garden Contracting Co.
Issued. 8-19-39

County Rice.



CASING.

10 3/4" 91' 7" 3378'

elevation.

Production. Pot. 437 B.

Figures Indicate Bottom of Formations.

water sand	66
red bed and lime shells	100
shale	620
salt	650
salt and shale	740
shale and shells	1040
broken limo	1100
shale and shells	1370
shale and lime	1925
shale and shell	2430
limo	2685
broken limo	2870
limo	3285
shale and shell	3378
conglomerate	3389
shale green	3390

Total Depth.

RECEIVED
STATE CORPORATION COMMISSION
MAY 23 1952
CONSERVATION DIVISION
Wichita, Kansas

15.159.05445.0000

SIMON LEBOW
OIL PRODUCER
807 PALACE BUILDING
TULSA 3, OKLAHOMA
January 17, 1947

State Corporation Commission
800 Bitting Building
Wichita, Kansas

Gentlemen: G.A.Engelland, Rice County, Kan.


Inclosed herewith is completed Well Plugging Record on the
above captioned lease.

Yours very truly,



Simon Lebow

SL/y

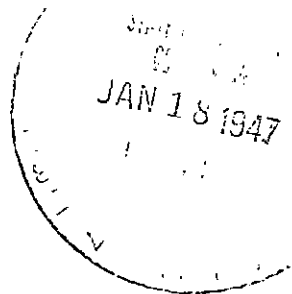

15 21 7W
82 12