


STATE OF KANSAS
STATE CORPORATION COMMISSION
CONSERVATION DIVISION
P. O. BOX 17027
WICHITA, KANSAS 67217

FORM CP-4

WELL PLUGGING RECORD

Hodgeman CV County, Sec 30 Twp 21S Rge 23W (E) (W)

Location as "NE/CNW/SE/SW" or footage from lines NW SW
Lease Owner PICKRELL DRILLING COMPANY
Lease Name TAMMEN "C" Well No. 1
Office Address LITWIN BLDG. SUITE 205 WICHITA, KS. 67202
Character of Well (completed as Oil, Gas or Dry Hole) Dry Hole
Date well completed 2-3-76 19
Application for plugging filed 2-3-76 19
Application for plugging approved 2-3-76 19
Plugging commenced 2-3-76 19
Plugging completed 2-3-76 19
Reason for abandonment of well or producing formation Dry Hole

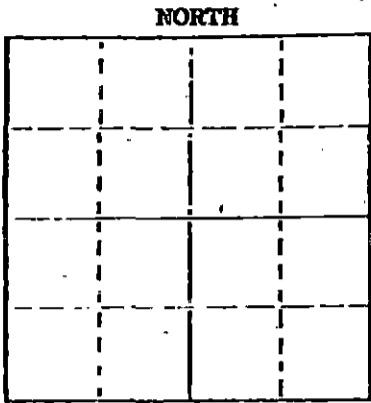

Locate well correctly on above Section Plat

If a producing well is abandoned, date of last production _____ 19____
Was permission obtained from the Conservation Division or its agents before plugging was commenced? _____

Name of Conservation Agent who supervised plugging of this well _____
Producing formation _____ Depth to top _____ Bottom _____ Total Depth of Well 4670 feet
Show depth and thickness of all water, oil and gas formations.

OIL, GAS OR WATER RECORDS

CASING RECORD

FORMATION	CONTENT	FROM	TO	SIZE	PUT IN	PULLED OUT
				8 5/8	216	None

Describe in detail the manner in which the well was plugged, indicating where the mud fluid was placed and the method or methods used in introducing it into the hole. If cement or other plugs were used, state the character of same and depth placed, from _____ feet to _____ feet for each plug set.

FEB 10 1976

CONSERVATION DIVISION
Wichita, Kansas

Bottom Plug 500'
50 sks. 210'
25 sks. 40'
2-3-76 2-6-76

Name of Plugging Contractor Pickrell Drilling Company (If additional description is necessary, use BACK of this sheet)
Address Litwin Bldg. Suite 205, Wichita, Ks. 67202

STATE OF Kansas COUNTY OF Sedgwick ss.
C. W. Sebitts (employee of owner) or (owner or operator) of the above-described well, being first duly sworn on oath, says: That I have knowledge of the facts, statements, and matters herein contained and the log of the above-described well as filed and that the same are true and correct. So help me God.

(Signature) C. W. Sebitts
Litwin Bldg., Suite 205 Wichita, Ks. 02
(Address)

Subscribed and sworn to before me this 6 day of February, 19 76

Helen L. Martin

Helen L. Martin, Notary Public.

My commission expires _____
STATE NOTARY PUBLIC
HELEN L. MARTIN
Sedgwick County, Ks.
My Appmt. Exp. Aug. 19, 1979

ROTARY DRILLING LOG

15.083.20459.0000

COMPANY: PICKRELL DRILLING COMPANY
LITWIN BLDG. SUITE 205
WICHITA, KS. 67202
LOCATION: TAMMEN "C" #1
NW SW 30-21S-23W
Hodgeman Co., Kansas
CONTRACTOR: PICKRELL DRILLING COMPANY
Wichita, Kansas

Rotary Drilling Commenced 1-22-76
Rotary Drilling Completed 2-3-76

CASING RECORD: 8 5/8 surface casing set at 216' with 140 sacks cement.

LOG

(Figures indicate bottom of formation — measurements from top of rotary bushing.)

Surface clay & sd.	100
Shale	218
Shale	635
Shale	1132
Sand	1321
Shale	1630
Shale & Red Bed	1658
Shale	1695
Shale	1980
Shale & Lime	2385
Lime & Shale	2475
Lime & Shale	2635
Lime & Shale	2765
Shale & Lime	2877
Lime & Shale	3005
Lime & Shale	3150
Lime & Shale	3280
Lime & Shale	3430
Lime & Shale	3540
Lime & Shale	3665
Lime & Shale	3810
Lime	3935
Lime	4000
Lime	4100
Lime	4178
Lime	4265
Lime	4340
Lime	4412
Lime	4470
Lime	4525
Lime	4575
Lime & Shale	4610
Shale	4622
Dolomite	4630
Dolomite	4640
Dolomite	4650
Dolomite	4670

RECEIVED
STATE CORPORATION COMMISSION

FEB 10 1976

CONSERVATION DIVISION
Wichita, Kansas

The undersigned, C. W. Sebitts, Attorney-in-Fact for PICKRELL DRILLING COMPANY, hereby certifies in behalf of said Company, that the above is a true and correct log of the formation encountered in drilling the above well as reflected by the Daily Drilling Reports.

PICKRELL DRILLING COMPANY

By [Signature]
C. W. Sebitts Attorney-in-Fact


STATE OF KANSAS }
COUNTY OF SEDGWICK } ss.:

On this 6 day of February, 1976, before me the undersigned, a Notary Public, in and for the County and State aforesaid, personally appeared C. W. Sebitts

, to me known to be the identical person who subscribed the name of PICKRELL DRILLING COMPANY to the foregoing instrument as its Attorney-in-Fact and acknowledged to me that he executed the same as his free and voluntary act and deed, and as the free and voluntary act and deed of such company, for the uses and purposes therein set forth.

Given under my hand and seal of office the day and year last above written.

My commission expires:

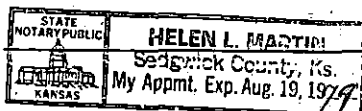

[Signature]
Notary Public
Helen L. Martin