


STATE OF KANSAS
STATE CORPORATION COMMISSION

Form CP-4

WELL PLUGGING RECORD

Give All Information Completely
Make Required Affidavit
Mail or Deliver Report to:
Conservation Division
State Corporation Commission
P. O. Box 17027

Wichita, Kansas 67217
NORTH

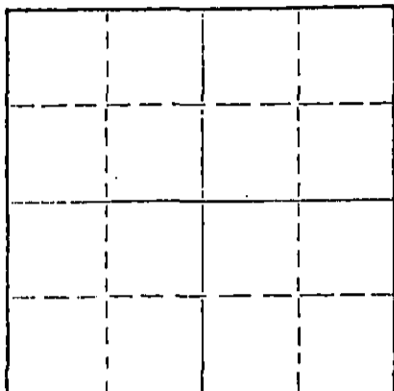

Locate well correctly on above
Section Plat

Hodgeman County, Sec. 30 Twp. 21S Rge. (E) 23 (W)
Location as "NE/CNW/SW" or footage from lines. C NW SE
Lease Owner Rains & Williamson Oil Co., Inc.
Lease Name Smith Well No. #1
Office Address 435 Page Court, 220 W. Douglas, Wichita, Ks. 67202
Character of Well (completed as Oil, Gas or Dry Hole) Dry Hole
Date well completed 4-27-77 19
Application for plugging filed 4-27-77 19
Application for plugging approved 4-27-77 19
Plugging commenced 4-27-77 19
Plugging completed 4-27-77 19
Reason for abandonment of well or producing formation
Commercial quantities of oil not found
If a producing well is abandoned, date of last production 19
Was permission obtained from the Conservation Division or its agents before plugging was commenced? Yes

Name of Conservation Agent who supervised plugging of this well Clarence Thomas, Garden City, Kansas
Producing formation _____ Depth to top _____ Bottom _____ Total Depth of Well 4637' Feet
Show depth and thickness of all water, oil and gas formations.

OIL, GAS OR WATER RECORDS

CASING RECORD

FORMATION	CONTENT	FROM	TO	SIZE	PUT IN	PULLED OUT
				8 5/8"	244'	None

Describe in detail the manner in which the well was plugged, indicating where the mud fluid was placed and the method or methods used in introducing it into the hole. If cement or other plugs were used, state the character of same and depth placed, from _____ feet to _____ feet for each plug set.

Plug @ 900' w/50 sx.
Plug @ 240' w/35 sx.
Plug @ 40' w/15 sx.
Rat Hole 5 sx.

RECEIVED
STATE CORPORATION COMMISSION

MAY 11 1977

CONSERVATION DIVISION
Wichita, Kansas

5-11-77

(If additional description is necessary, use BACK of this sheet)

Name of Plugging Contractor Rains & Williamson Oil Co., Inc.
Address 435 Page Court, 220 W. Douglas, Wichita, Kansas 67202

STATE OF Kansas, COUNTY OF Sedgwick, ss.

Wilson Rains President of Rains & Williamson Oil Co., Inc. (employee of owner) or (owner or operator) of the above-described well, being first duly sworn on oath, says: That I have knowledge of the facts, statements, and matters herein contained and the log of the above-described well as filed and that the same are true and correct. So help me God.

(Signature) Wilson Rains

435 Page Court, 220 W. Douglas, Wichita, Ks. 67202
(Address)

day of May 10, 1977

My commission expires 10-4-79



Juanita M. Green
Notary Public.

DRILLER'S LOG

COMPANY: Rains & Williamson Oil Co., Inc.

SEC. 30 T. 21S R. 23W

WELL NAME: Smith #1

LOC. C NW SE

RIG NO. #2

COUNTY: Hodgeman

TOTAL DEPTH 4637'

ELEVATION 2394 KB

COMMENCED: 4-18-77

COMPLETED: 4-27-77

CONTRACTOR: Rains & Williamson Oil Co., Inc.

CASING RECORD:

SURFACE: 8 5/8" @ 244' w/165 sx. 60/40 poz., 2% gel, 3% cc.

PRODUCTION: D&A

LOG

(Figures Indicate Bottom of Formations)

Clay, Sand & Shale	255
Shale	2424
Shale & Lime	3505
Lime & Shale	3885
Shale & Lime	4065
Lime	4637
<u>ROTARY TOTAL DEPTH</u>	<u>4637</u>

RECEIVED
STATE CORPORATION COMMISSION
MAY 11 1977
CONSERVATION DIVISION
Wichita, Kansas

STATE OF Kansas)
COUNTY OF Sedgwick)

SS:

I, Wilson Rains, President of Rains & Williamson Oil Co., Inc.
upon oath state that the above and foregoing is a true and correct copy of the log of the
Smith #1 well.

Wilson Rains

Wilson Rains

Subscribed and sworn to before me this 10 day of May, 19 77.

My Appointment Expires:

10-4-79

Juanita M. Green
Juanita M. Green

