


WELL PLUGGING RECORD

Give All Information Completely
Make Required Affidavit
Mail or Deliver Report to:
Conservation Division
State Corporation Commission
211 No. Broadway
Wichita, Kansas

Hodgeman County. Sec. 23 Twp. 21S Rge. 23 (W)
Ctr. NW SE

Location as "NE/CNW/SW" or footage from lines
Lease Owner Champlin Petroleum Company
Lease Name Holtsberg Well No. 1
Office Address P. O. Box 308, Ellinwood, Kansas
Character of Well (completed as Oil, Gas or Dry Hole) Dry Hole
Date well completed February 16 19 67
Application for plugging filed February 16 19 67
Application for plugging approved February 16 (Verbal) 19 67
Plugging commenced February 16 19 67
Plugging completed February 16 19 67
Reason for abandonment of well or producing formation

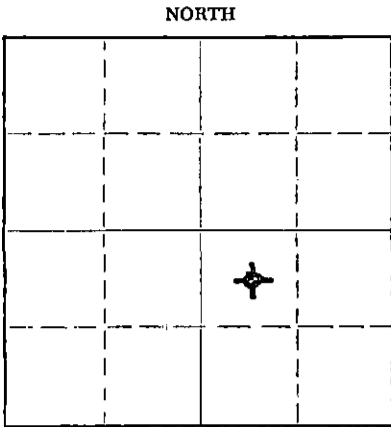

Locate well correctly on above
Section Plat

If a producing well is abandoned, date of last production 19
Was permission obtained from the Conservation Division or its agents before plugging was commenced? Yes

Name of Conservation Agent who supervised plugging of this well
Producing formation Depth to top Bottom Total Depth of Well 4595 Feet
Show depth and thickness of all water, oil and gas formations.

OIL, GAS OR WATER RECORDS

CASING RECORD

FORMATION	CONTENT	FROM	TO	SIZE	PUT IN	PULLED OUT
				8 5/8" OD	217	None

Describe in detail the manner in which the well was plugged, indicating where the mud fluid was placed and the method or methods used in introducing it into the hole. If cement or other plugs were used, state the character of same and depth placed, from feet to feet for each plug set.

Filled hole with heavy rotary mud to 650' and pumped in 35 sacks of cement then mud to 210', pushed a wooden plug to 210' and pumped in 15 sacks of cement and pushed in one sack of hulls then mud to 20' and pushed a wooden plug to 20' and pumped in 10 sacks cement filling hole to top. (Cement is 2' below ground level).

RECEIVED
STATE CORPORATION COMMISSION
FEB 21 1967
2-21-67
CONSERVATION DIVISION
Wichita, Kansas

(If additional description is necessary, use BACK of this sheet)
Name of Plugging Contractor Red Tiger Drilling Company
Address 1720 Wichita Plaza, Wichita, Kansas

STATE OF Kansas, COUNTY OF Barton, ss.
J. W. Meyers (employee of owner) or (owner) of the above-described well, being first duly sworn on oath, says: That I have knowledge of the facts, statements, and matters herein contained and the log of the above-described well as filed and that the same are true and correct. So help me God.

(Signature) J. W. Meyers, Dist. Opt's. Mgr.
Box 308, Ellinwood, Kansas
(Address)

SUBSCRIBED AND SWORN TO before me this 20th day of February, 19 67

My commission expires 5/22/70

Notary Public.

DRILLERS LOG

Holtsberg No. 1

CASING RECORD: 8 5/8" @ 216.69' w/175 ex cement
 COMPANY: Champlin Petroleum Co
 CONTRACTOR: Red Tiger Drilling Co.
 COMMENCED: February 3, 1967
 COMPLETED: February 16, 1967
 DESCRIPTION: C NW SE 23-21S-23W Hodgeman Co., Ks.
 ELEVATION:
 TOTAL DEPTH: 4595'

<u>FORMATION</u>	<u>FROM</u>	<u>TO</u>	<u>REMARKS</u>
Surf. Soil & Shale	0	180	
Hard Blue Shale	180	208	
White Chay	208	218	
Sandy Shale & Shells	218	615	
Red Bed	615	903	
Blane	903	913	
Shale & Shells	913	988	
Sand	988	1183	
Shale & Shells	1183	1519	
Anhydrite, Shale & Shells	1519	1780	
Shale	1780	2260	
Shale & Lime	2260	3846	
Heebner	3846	3850	
Lime & Shale	3850	3925	
Lime	3925	4285	
Lime & Shale (Marm)	4285	4380	
Lime & Shale, Ft. Scott	4380	4555	
Mississippi	4555	4595	

RECEIVED
 STATE CORPORATION COMMISSION
 FEB 27 1967
 CONSERVATION DIVISION
 Topeka, Kansas

I certify that this is a true and correct copy of the above log to the best of my knowledge.

RED TIGER DRILLING COMPANY

Maxine V. Starr
 Maxine V. Starr

Subscribed and sworn to before me this 21st day of February, 1967.

Jean Stella
 Notary Public

My Commission Expires:
5-22-70

