


STATE OF KANSAS
STATE CORPORATION COMMISSION

Form CP-4

Give All Information Completely
Make Required Affidavit
Mail or Deliver Report to:
Conservation Division
State Corporation Commission
P. O. Box 17027
Wichita, Kansas 67217
NORTH

WELL PLUGGING RECORD

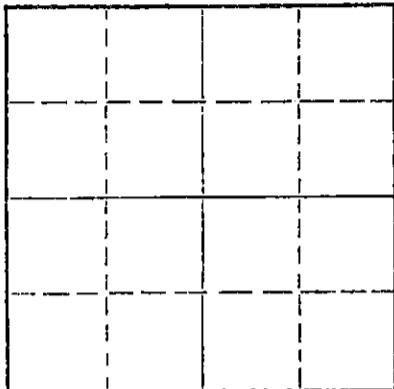

Locate well correctly on above
Section Plat

Hodgeman County, Sec. 16 Twp. 21S Rge. 23W (E) (W)
Location as "NE/CNW/SE/SW" or footage from lines C SW SW
Lease Owner Pickrell Drilling Company
Lease Name Folkerts "B" Well No. 1
Office Address 705 Fourth Nat'l. Bank Bldg., Wichita, Ks.
Character of Well (completed as Oil, Gas or Dry Hole) Dry Hole
Date well completed April 28 1973
Application for plugging filed April 28 1973
Application for plugging approved April 28 1973
Plugging commenced April 28 1973
Plugging completed April 28 1973
Reason for abandonment of well or producing formation D & A

If a producing well is abandoned, date of last production 19__
Was permission obtained from the Conservation Division or its agents before plugging was commenced? Yes

Name of Conservation Agent who supervised plugging of this well Edgar J. Eves
Producing formation _____ Depth to top _____ Bottom _____ Total Depth of Well 4655 Feet
Show depth and thickness of all water, oil and gas formations.

OIL, GAS OR WATER RECORDS

CASING RECORD

FORMATION	CONTENT	FROM	TO	SIZE	PUT IN	PULLED OUT
				8 5/8"	252'	None

Describe in detail the manner in which the well was plugged, indicating where the mud fluid was placed and the method or methods used in introducing it into the hole. If cement or other plugs were used, state the character of same and depth placed, from _____ feet to _____ feet for each plug set.

Bottom Plug @ 800' w/80 sacks, Middle Plug @ 250' w/30 sacks, Top Plug @ 45' w/10 sacks.

RECEIVED
STATE CORPORATION COMMISSION
MAY 7 1973
CONSERVATION DIVISION
Wichita, Kansas

(If additional description is necessary, use BACK of this sheet)

Name of Plugging Contractor Pickrell Drilling Company
Address 705 Fourth National Bank Building, Wichita, Kansas 67202

STATE OF KANSAS, COUNTY OF SEDGWICK, ss.

C. W. Sebitts (XXXXXXXXXXXX) or (owner or operator) of the above-described well, being first duly sworn on oath, says: That I have knowledge of the facts, statements, and matters herein contained and the log of the above-described well as filed and that the same are true and correct. So help me God.

(Signature) C. W. Sebitts
705 Fourth National Bank Building, Wichita, Ks.

Subscribed and sworn to before me this 3rd day of May, 1973

Ruth M. Sullivan
Notary Public.

My commission expires August 13, 1973


ROTARY DRILLING LOG

COMPANY: Pickrell Drilling Company
705 Fourth National Bank Building
Wichita, Kansas 67202
LOCATION: Folkerts "B" No. 1, C SW SW Sec. 16-21S-23W
Hodgeman County, Kansas

Rotary Drilling Commenced 4/16/73
Rotary Drilling Completed 4/28/73

CONTRACTOR: **PICKRELL DRILLING COMPANY**
Wichita, Kansas

CASING RECORD: Run 6 jts. 8 5/8" surface casing set at 252' K.B. Cemented with 150 sacks. Completed 7:30 P.M. Circulated.

No oil string run. D & A.

LOG

(Figures indicate bottom of formation — measurements from top of rotary bushing.)

85	Top Soil - Sand		<u>C. F. S.</u>
256	Shale	4500	
995	Shale & Red Bed	4560	
1010	Blaine	4570	
1095	Shale	4580	
1285	Sand	4590	
2065	Shale	4600	
2280	Shale & Lime	4614	
2520	Lime & Shale	4625	
3250	Lime		
3760	Shale & Lime		
3930	Lime & Shale		
4570	Lime		
4600	Chert & Lime		
4614	Chert		
4655	Mississippi, RTD		

RECEIVED
STATE CORPORATION COMMISSION
MAY 7 1973
CONSERVATION DIVISION
Wichita, Kansas

Slope Tests
3000
2500
3000
3500
4000
4500

The undersigned, C. W. Sebitts, Attorney-in-Fact for PICKRELL DRILLING COMPANY, hereby certifies in behalf of said Company, that the above is a true and correct log of the formation encountered in drilling the above well as reflected by the Daily Drilling Reports.

PICKRELL DRILLING COMPANY
By [Signature]
Attorney-in-Fact

STATE OF KANSAS }
COUNTY OF SEDGWICK } ss.:

On this 3rd day of May, 19 73, before me the undersigned, a Notary Public, in and for the County and State aforesaid, personally appeared C. W. Sebitts, to me known to be the identical person who subscribed the name of PICKRELL DRILLING COMPANY to the foregoing instrument as its Attorney-in-Fact and acknowledged to me that he executed the same as his free and voluntary act and deed, and as the free and voluntary act and deed of such company, for the uses and purposes therein set forth.
Given under my hand and seal of office the day and year last above written.

My commission expires: August 13, 1973

[Signature]
Ruth M. Sullivan Notary Public