

KANSAS  
 STATE CORPORATION COMMISSION  
 200 Colorado Derby Building  
 Wichita, Kansas 67202

WELL PLUGGING RECORD  
 K.A.R.-82-3-117

15.145.20028.0000

API NUMBER N/A

LEASE NAME Chaddick

WELL NUMBER 3

1320 Ft. from S Section Line

1320 Ft. from E Section Line

SEC. 31 TWP. 20 SRGE. 20 (E) (W)

COUNTY Pawnee

Date Well Completed 10/5/67

Plugging Commenced 2/26/88

Plugging Completed 3/3/88

LEASE OPERATOR Pickrell Drilling Co., Inc.

ADDRESS 110 N. Market, Suite #205, Wichita, KS 67202

PHONE#(316) 262-8427 OPERATORS LICENSE NO. 5123

Character of Well Oil

(Oil, Gas, D&A, SWD, Input, Water Supply Well)

Did you notify the KCC/KDHE Joint District Office prior to plugging this well? yes

Which KCC/KDHE Joint Office did you notify? Ness City (1/7/88) Dan Goodrow

Is ACO-1 filed? yes If not, is well log attached? \_\_\_\_\_

Producing Formation Mississippi Depth to Top 4380 Bottom T.D. 4386

Show depth and thickness of all water, oil and gas formations.

OIL, GAS OR WATER RECORDS

CASING RECORD

Formation	Content	From	To	Size	Put in	Pulled out
		273	0	8 5/8"	273	none
		4381	0	5 1/2"	4381	none

Describe in detail the manner in which the well was plugged, indicating where the mud fluid was placed and the method or methods used in introducing it into the hole. If cement or other plugs were used, state the character of same and depth placed, from feet to feet each set.

Pump down 5 1/2" casing: 300# hulls in water, 100 sx Allied Cementing Co. ATL cement (170# of hulls in first cement). Pressure went to 2000#. Shut in with 100#. After 5 days fill from 760 (top of cement) to surface with cement.

(If additional description is necessary, use BACK of this form.)

Name of Plugging Contractor Allied Cementing Co. License No. N/A

Address Box 31, Russell, KS 67665

STATE OF Kansas COUNTY OF Sedgwick, ss.

Jack Gurley (Employee of Operator) or (Operator) of

above-described well, being first duly sworn on oath, says: That I have knowledge of the facts, statements, and matters herein contained and the log of the above-described well as filed that the same are true and correct, so help me God.

(Signature) Jack Gurley

(Address) Jack Gurley, Engineer

110 N. Market, Suite #205,

Wichita, KS 67202

SUBSCRIBED AND SWORN TO before me this 25th day of March, 1988

Susan Kendall  
 Notary Public

My Commission Expires: 10/6/91 Susan Kendall




RECEIVED  
 STATE CORPORATION COMMISSION  
 MAR 28 1988

BAKER SERVICE TOOLS - TALLY PAD

New Completion  Workover

15.145.20028.0000

Oil Company \_\_\_\_\_ Well No. 3 Field Steffen Lease Chaddick  
Company Man \_\_\_\_\_ Date Drilled 10/67 County Pawnee State Kansas

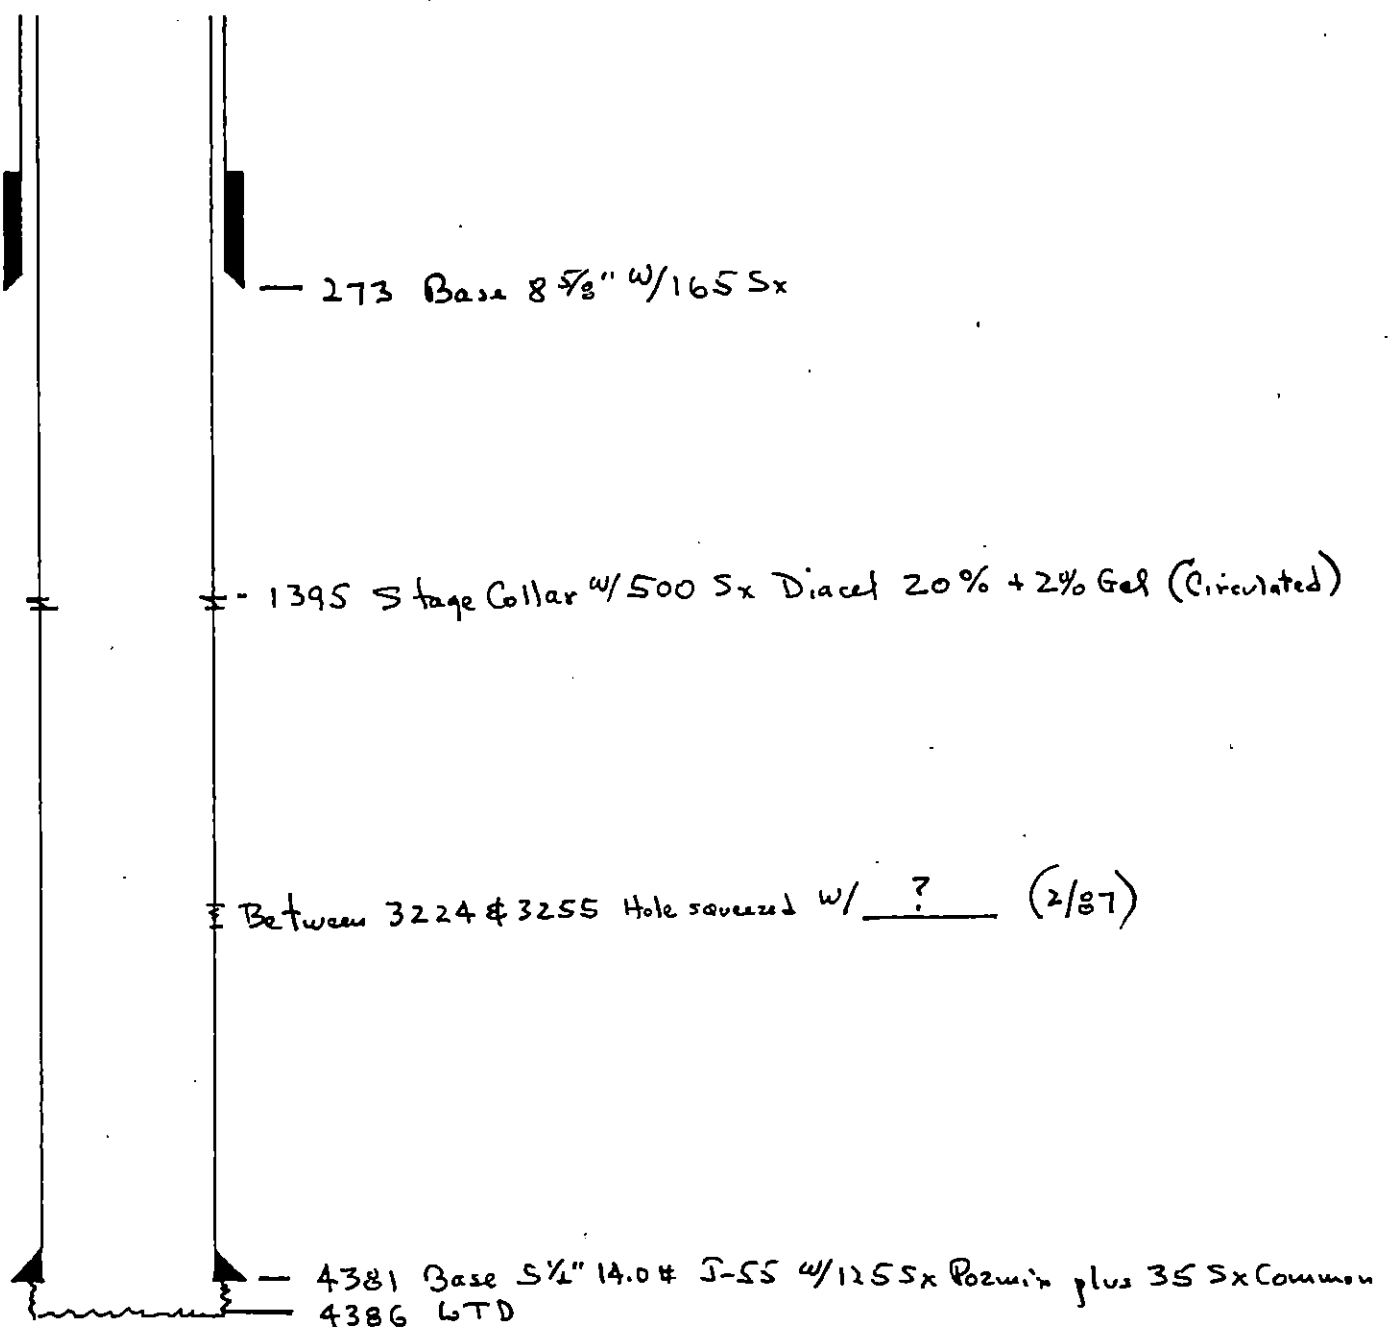

REMARKS: Csg Cap = 600 ft <sup>3</sup> to 4381'

RECEIVED  
STATE CORPORATION COMMISSION

NOV 07 1988

CONSERVATION DIVISION  
Wichita, Kansas