


Give All Information Completely
Make Required Affidavit
Mail or Deliver Report to:
Conservation Division
State Corporation Commission
211 West Broadway
Wichita, Kansas

WELL PLUGGING RECORD

NORTH

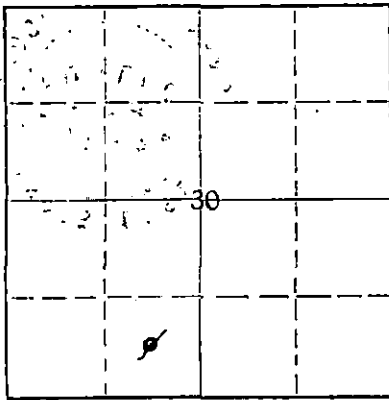

Locate well correctly on above Section Plat

Pawnee County, Sec. 30 Twp. 20S Rge. (E) 20 (W)
Location as "NE/CNW/SW" or footage from lines C SE SW
Lease Owner Lario Oil & Gas Company
Lease Name Steffen Well No. 5
Office Address 301 S. Market, Wichita, Kansas 67202
Character of Well (completed as Oil, Gas or Dry Hole) Oil
Date well completed October 10 1965
Application for plugging filed January 18 1974
Application for plugging approved January 21 1974
Plugging commenced February 7 1974
Plugging completed February 14 1974
Reason for abandonment of well or producing formation Injection Project Abandoned

If a producing well is abandoned, date of last production Inj. well ST 4-30-70
Was permission obtained from the Conservation Division or its agents before plugging was commenced? Yes

Name of Conservation Agent who supervised plugging of this well Leo Massey
Producing formation Mississippi Depth to top 4330 Bottom Total Depth of Well 4391 Feet
Show depth and thickness of all water, oil and gas formations.

OIL, GAS OR WATER RECORDS

CASING RECORD

FORMATION	CONTENT	FROM	TO	SIZE	PUT IN	PULLED OUT
				8 5/8	525	None
				5 1/2	4396	2759'

Describe in detail the manner in which the well was plugged, indicating where the mud fluid was placed and the method or methods used in introducing it into the hole. If cement or other plugs were used, state the character of same and depth placed, from feet to feet for each plug set.

Dumped 4 sacks cement at 4300'. Pumped 7 sacks gel, 70 sacks cement; 15 barrels of water; 20 sacks cement cap. Left 100' cement in surface pipe under 400# pressure.

RECEIVED
STATE CORPORATION COMMISSION
FEB 20 1974
CONSERVATION DIVISION
Wichita, Kansas

(If additional description is necessary, use BACK of this sheet)

Name of Plugging Contractor Nicholas Casing Pulling
Address Box 373, Geneseo, Kansas 67444


STATE OF Kansas, COUNTY OF Sedgwick, ss.
M. E. Kraft (employee of owner) or (owner/operator) of the above-described well, being first duly sworn on oath, says: That I have knowledge of the facts, statements, and matters herein contained and the log of the above-described well as filed and that the same are true and correct. So help me God.

(Signature) *M. E. Kraft*
301 S. Market, Wichita, Kansas 67202
(Address)

SUBSCRIBED AND SWORN to before me this 19th day of February, 1974

My commission expires July 21, 1974

Francis Leake
Notary Public.

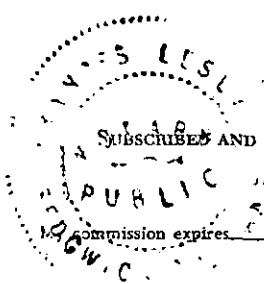

LARIO OIL & GAS COMPANY
 Steffen No. 5
 Approx. 25' SW of Cen. SE SW Sec. 30-20S-20W
 Pawnee County, Kansas

Drilling Commenced: September 21, 1965
 Drilling Completed: October 1, 1965
 Well Completed: October 10, 1965
 Drilling Contractor: Gabbert-Jones, Inc.
 Total Depth: 4391' Driller's
 4397' Elec. Log
 Initial Potential: 45 bbls. oil + 115 bbls. water per day

RECEIVED
 STATE CORPORATION COMMISSION
 JAN 21 1974
 CONSERVATION DIVISION
 Wichita, Kansas

Casing Record:

8 5/8" Set @ 525'
 Cem. w/ 300 sacks
 5 1/2" Set @ 4396'
 Cem. w/ 100 sacks

<u>Formation</u>	<u>Depth</u>
Post rock	80
Shale	525
Red bed	635
Shale	699
Anhydrite	707
Shale	795
Sand	1000
Shale	1360
Anhydrite	1386
Shale & shells	2000
Shale	2175
Shale & lime	3733
Lime	4160
Lime & shale	4265
Lime	4328
Chert & lime	4340
Mississippi	4391

GEOLOGICAL TOPS - K.B. Meas.

	(Corr. to Elec. Log)
Elevation	2187' D.F.
	2189' K.B.
Heebner	3706' (-1517')
Lansing	3756' (-1567')
Fort Scott	4265' (-2076')
Cherokee	4283' (-2094')
Mississippian	4330' (-2141')
Mississippian Lime	4379' (-2190')
Elec. Log T.D.	4397'
Driller's T.D.	4391'