


STATE OF KANSAS  
STATE CORPORATION COMMISSION

CORRECTED

Form CP-4

WELL PLUGGING RECORD

Give All Information Completely  
Make Required Affidavit  
Mail or Deliver Report to:  
Conservation Division  
State Corporation Commission  
P. O. Box 17027  
Wichita, Kansas 67217  
NORTH

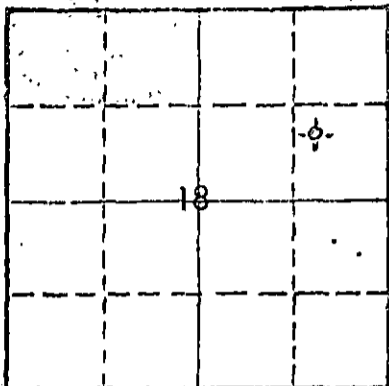

Locate well correctly on above  
Section Plat

PAWNEE County, Sec. 18 Twp. 20S Rge. (E) 20(W)

Location as "NE/CNWSW" or footage from lines NW SE NE

Lease Owner PARRISH OIL COMPANY

Lease Name STEFFEN Well No. 1

Office Address 714 FOURTH NATIONAL BLDG., WICHITA, KS 67202

Character of Well (completed as Oil, Gas or Dry Hole) DRY HOLE

Date well completed DECEMBER 5 1974

Application for plugging filed DECEMBER 5 1974

Application for plugging approved DECEMBER 5 1974

Plugging commenced DECEMBER 5 1974

Plugging completed DECEMBER 5 1974

Reason for abandonment of well or producing formation TOO LOW STRUCTURALLY

If a producing well is abandoned, date of last production 19

Was permission obtained from the Conservation Division or its agents before plugging was commenced? YES

Name of Conservation Agent who supervised plugging of this well LEO F MASSEY, HAYS, KANSAS

Producing formation \_\_\_\_\_ Depth to top \_\_\_\_\_ Bottom \_\_\_\_\_ Total Depth of Well \_\_\_\_\_ Feet

Show depth and thickness of all water, oil and gas formations.

OIL, GAS OR WATER RECORDS

CASING RECORD

FORMATION	CONTENT	FROM	TO	SIZE	PUT IN	PULLED OUT
				8 5/8"	317'	NONE

Describe in detail the manner in which the well was plugged, indicating where the mud fluid was placed and the method or methods used in introducing it into the hole. If cement or other plugs were used, state the character of same and depth placed, from \_\_\_\_\_ feet to \_\_\_\_\_ feet for each plug set.

FILLED WITH HEAVY MUD TO 550', SET  
PLUG. PUT IN 50 SACKS CEMENT. FILLED  
WITH HEAVY MUD TO 240'. SET PLUG.  
PUT IN 25 SACKS CEMENT. FILLED WITH MUD  
TO 40'. SET PLUG. FILLED TO TOP WITH  
1 SACK HULLS & 10 SACKS CEMENT.

RECEIVED  
STATE CORPORATION COMMISSION

JAN 2 1974

CONSERVATION DIVISION  
Wichita, Kansas

Name of Plugging Contractor C-G DRILLING CO.  
Address 1107 UNION NATIONAL BUILDING, WICHITA, KANSAS 67202

STATE OF KANSAS, COUNTY OF SEDGWICK

G F GALLOWAY

(employee of owner) or (owner or operator) of the above-described well, being first duly sworn on oath, says: That I have knowledge of the facts, statements, and matters herein contained and the log of the above-described well as filed and that the same are true and correct. So help me God.

(Signature)

G F Galloway  
1107 Union National Bldg, Wichita, Ks.  
(Address)

Sworn to before me this 5th day of December 1974

December 7, 1974

Phyllis Buchanan  
Phyllis Buchanan - Notary Public.



W E L L L O G

OPERATOR: PARRISH OIL COMPANY

WELL NAME: STEFFEN #1 LOCATION: NW SE NE

COUNTY: PAWNEE STATE: KANSAS

WELL COMMENCED: NOV 22 '74 WELL COMPLETED: DEC 5 '74

ELEVATION: 2233 KB TOTAL DEPTH: 4400'

PRODUCTION: DRY & ABANDONED RIG NO: 1

CASING - 8-5/8": SET @ 317' (7 JTS) NEW 24# 8 5/8" W/185 SX 60-40  
POZMIX 2% GEL 3% CA CL

5-1/2": .....

ALL MEASUREMENTS TAKEN FROM THE TOP OF ROTARY BUSHING:

FROM	TO	FORMATION	DEVIATION FROM VERTICAL	REMARKS:
0	735	SHALE & SAND		
735	850	RED BED		
850	1060	SAND		
1060	1412	RED BED		
1412	1441	ANHYDRITE	1° @ 1789'	
1441	1829	SAND & SHALE		
1829	2030	SHALE		
2030	3860	SHALE & LIME		
3860	4390	LIME		
4390	4400	MISSISSIPPI		
	4400	RTD		

DST #1 4378-85' MISRUN  
DST #2 4380'-4390'  
OPEN 20 SI 60 OPEN 60 SI 90  
REC 85' MUD W/OIL SPECKS.  
IBHP 1350# FBHP 1350#  
IFP 72# FFP 91#  
DST #3 PACKER FAILURE  
DST #4 PACKER FAILURE  
DST #5 4385'-4400'  
OPEN 20 SI 60 OPEN 60 SI 90  
REC 100' WATERY MUD.  
IBHP 1317# FBHP 1263#  
IFP 32# FFP 65#

STATE OF KANSAS )  
COUNTY OF SEDGWICK) SS:

The undersigned hereby certifies that to the best of his knowledge and belief, the above facts are true and correct.


C-G DRILLING CO.

By Jay H. Galloway

SUBSCRIBED AND SWORN TO, BEFORE ME, This 12th day of Dec., 1974.

MY COMM. EXP. DEC. 7, 1975

Phyllis Buchanan  
PHYLLIS BUCHANAN - NOTARY PUBLIC

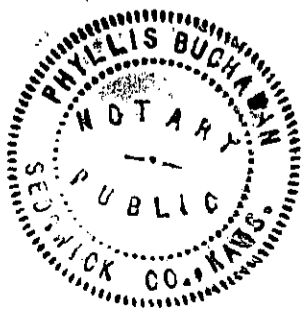

RECEIVED  
STATE CORPORATION COMMISSION

DEC 27 1974

CONSERVATION DIVISION  
Wichita, Kansas