


STATE OF KANSAS
STATE CORPORATION COMMISSION

WELL PLUGGING RECORD

Give All Information Completely
Make Required Affidavit
Mail or Deliver Report to
Conservation Division
State Corporation Comm.
245 North Water
Wichita, KS 67202

Ness County, Sec. 21 Twp. 20S Rge. 23E2W
Location as "NE/CNW $\frac{1}{4}$ SW $\frac{1}{4}$ " or footage from lines
C NE NW

Lease Owner Hoppe Oil & Gas Co.
Lease Name Burditt Well No. 1
Office Address Box 18678, Wichita, Kansas 67218
Character of Well (Completed as Oil, Gas or Dry Hole)
dry hole

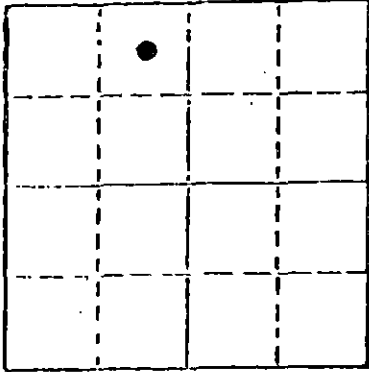

Locate well correctly on above
Section Plot

Date Well completed 5-09 1981
Application for plugging filed 5-09 1981
Application for plugging approved 5-09 1981
Plugging commenced 5-09 1981
Plugging completed 5-09 1981
Reason for abandonment of well or producing formation
No commercial quantity of oil or gas encountered.
If a producing well is abandoned, date of last production
19

Was permission obtained from the Conservation Division or
its agents before plugging was commenced? yes

Name of Conservation Agent who supervised plugging of this well Marion Schmidt
Producing formation _____ Depth to top _____ Bottom _____ Total Depth of Well _____
Show depth and thickness of all water, oil and gas formations.

OIL, GAS OR WATER RECORDS

CASING RECORD

FORMATION	CONTENT	FROM	TO	SIZE	PUT IN	PULLED OUT

Describe in detail the manner in which the well was plugged, indicating where the mud fluid
was placed and the method or methods used in introducing it into the hold. If cement or other
plugs were used, state the character of same and depth placed, from _____ feet to
_____ feet for each plug set.

T.D. 4500'. Set 1st plug @ 840' with 65 sx., 2nd plug @ 270' with 10sx.,
bridge @ 40', 55 sx. in rat hole. Cement by Allied Cementing. Job
Completed @ 9:45 a.m. on 5-09-81. State plugger - Marion Schmidt

(If additional description is necessary, use BACK of this sheet)

Name of Plugging Contractor KAW Drilling Co., Inc.

STATE OF KANSAS COUNTY OF SEDGWICK, ss.
K.S. Martin, President of KAW Drilling Co., Inc. ~~competent and disinterested person~~
of the above-described well, being first duly sworn on oath, says: That I have knowledge of
the facts, statements, and matters herein contained and the log of the above-described well
as filed and that the same are true and correct. So help me God.

(Signature) K.S. Martin
K.S. Martin, President - 1010 Union Center
(Address) Wichita, KS 67202

SUBSCRIBED AND SWORN TO before me this 12th day of May, 1981.


My commission expires December 10, 1983

Mary Susan Whaley
Mary Susan Whaley Notary Public

RECEIVED
STATE CORPORATION COMMISSION

MAY 14 1981

CONSERVATION DIVISION
Wichita, Kansas

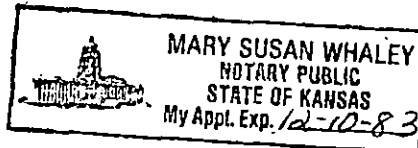

OPERATOR:
CONTRACTOR:
WELL NAME:
LOCATION:

SPUD DATE:
COMPLETION DATE:

HOPPE OIL & GAS CO.
KAW Drilling Co., Inc.
BURDITT #1
C NE NW Section 21-20S-23W
Ness County, Kansas
April 30, 1981
May 9, 1981

0	2049	Shale & Sand
2050	2368	Shale & Shell
2369	3238	Shale
3239	3456	Shale & Shell
3457	4343	Shale
4344	4419	Shale & Lime
4420	4500	Lime
	4500	R.T.D.

Spud hole @ 4:30 p.m. on 4/30/81. Drilled 777' of 12 1/2" hole. Ran 17 joints of 8 5/8" 23# new casinging. (Tallied 761.93') Set at 773' K.B. with 350 sx. of common cement, 2% Gel, 3% C.C. Plug was down @ 11:00 a.m. on 5/01/81.

T.D. 4500'. Set 1st plug @ 840' with 65 sx., 2nd plug @ 270' with 10 sx., bridge @ 40', 55 sx. in rat hole. Cement by Allied Cementing. Job completed @ 9:45 a.m. on 5/09/81. State plugger - Marion Schmidt.

STATE OF KANSAS)
) ss
COUNTY OF SEDGWICK)


I, K. S. Martin, President of KAW Drilling Co., Inc., being first duly sworn and upon my oath, state that: I have knowledge of the facts, statements, and matters herein contained and the log of the above described well as filed and that the same are true and correct. So help me God.

K. S. Martin
K. S. Martin, President

SUBSCRIBED AND SWORN to before me on this 12th day of May, 1981.

Mary Susan Whaley
Mary Susan Whaley, Notary Public

My Commission Expires:
December 10, 1983

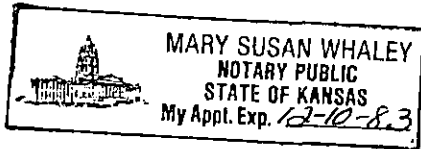

RECEIVED
STATE CORPORATION COMMISSION
MAY 14 1981
CONSERVATION DIVISION
Wichita, Kansas