


WELL PLUGGING RECORD

Give All Information Completely  
Make Required Affidavit  
Mail or Deliver Report to:  
Conservation Division  
State Corporation Commission  
211 No. Broadway  
Wichita, Kansas

Rice County. Sec. 28 Twp. 20 Rge. 7 (#/ (W)  
Location as "NE/CNW/SW" or footage from lines SE/SE/NW  
Lease Owner Aurora Gasoline Company  
Lease Name Willhouse Well No. # 1  
Office Address 1107 Un. Natl. Bldg. Wichita, Kansas  
Character of Well (completed as Oil, Gas or Dry Hole) \_\_\_\_\_  
Date well completed \_\_\_\_\_ 19\_\_\_\_  
Application for plugging filed Yes 19\_\_\_\_  
Application for plugging approved Yes 19\_\_\_\_  
Plugging commenced 9-29 19 58  
Plugging completed 10-2 19 58  
Reason for abandonment of well or producing formation \_\_\_\_\_

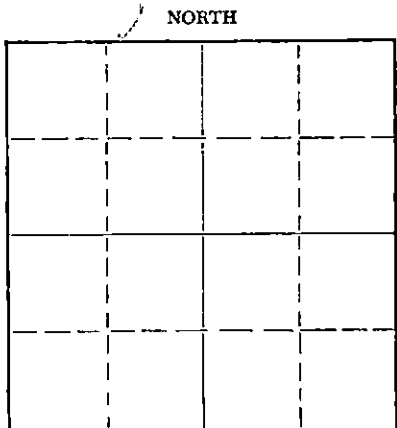

Locate well correctly on above Section Plat

If a producing well is abandoned, date of last production \_\_\_\_\_ 19\_\_\_\_  
Was permission obtained from the Conservation Division or its agents before plugging was commenced? Yes

Name of Conservation Agent who supervised plugging of this well Mr. Gilbert Toman  
Producing formation \_\_\_\_\_ Depth to top \_\_\_\_\_ Bottom \_\_\_\_\_ Total Depth of Well 3346' Feet  
Show depth and thickness of all water, oil and gas formations.

OIL, GAS OR WATER RECORDS				CASING RECORD		
FORMATION	CONTENT	FROM	TO	SIZE	PUT IN	PULLED OUT
				8 5/8"		
				5 1/2"		2,976'

Describe in detail the manner in which the well was plugged, indicating where the mud fluid was placed and the method or methods used in introducing it into the hole. If cement or other plugs were used, state the character of same and depth placed, from \_\_\_\_\_ feet to \_\_\_\_\_ feet for each plug set.

Measured into T.D. 3346'.  
Plugging started 9-29-58. Finished 10-2-58.  
Plugged off bottom with sand to 3335' and dumped 5 sacks cement.  
Shot 5 1/2" casing at 2,976'. Pulled pipe out of hole and plugged well as follows: Mudded to 220'. Set rock bridge and dumped 20 sacks cement. Filled hole with mud to 35'. Set rock bridge and mixed 10 sacks cement for cap on well. Well completed.

(If additional description is necessary, use BACK of this sheet)  
Name of Plugging Contractor J.O. Forbes d/b/a Forbes Casing Pulling Co.  
Address Box 221, Great Bend, Kansas

STATE OF Kansas, COUNTY OF Barton, ss.  
J.O. Forbes (employee of owner) or (owner or operator) of the above-described well, being first duly sworn on oath, says: That I have knowledge of the facts, statements, and matters herein contained and the log of the above-described well as filed and that the same are true and correct. So help me God.

(Signature) J.O. Forbes  
Box 221, Great Bend, Kans. (Address)

SUBSCRIBED AND SWORN TO before me this 6th day of October, 1958

My commission expires November 8, 1960.  
Betty S. Edmond  
STATE CORPORATION COMMISSION Notary Public.

PLUGGING  
FILE SEC. 28 T. 20 R. 7W  
BOOK PAGE 133 LINE 20

OCT 8 1958  
CONSERVATION DIVISION  
Wichita, Kansas  
10-8-1958

ROTARY DRILLED LOG

Company: Aurora Gasline Co.

Farm: Willhaus

Well No. 1

Location: SE SE NW Section 28--Township 20--Range 7W, Rice Co., Kansas

Well Commenced: June 14, 1956

Well Finished: June 24, 1956

Elevation: 1631 D.F.

Contractor: Galira Drilling Corp., Inc.

Surface pipe: 228 ft. 6 5/8" with 200 sacks cement 2% cc.

Oil String: 3323 ft. 5 1/2" casing cemented 75 sacks

Geologist: Mr. Douglas, Wichita, Kansas

0-20	surface soil	2155	shale and shells
60	sand	2430	shale and lime
228	shale and shells	2685	lime
1050	shale, shells, red beds	2875	lime and sand
1300	shale and shells	2940	lime and shale
1400	shale and lime	3290	lime
1790	lime	3329	shale, lime, chert
1955	lime and shale	T D 3325	

GEOLOGIST'S TOPS

Heebner	2712
Toronto	2730
Douglas	2730
Br. Lime	2870
Lansing	2899
E. Kansas City	3238
Chert Cong.	3320

The above log is true and correct to the best of my knowledge.

*Loren W. Hallen*

Subscribed and sworn to before me  
on this 27<sup>th</sup> day of June, 1956.

*Lorraine Claus*  
Notary Public

My commission expires:

*July 25, 1956*

PLUGGING

FILE SEC 28 T 20 R 7W

BOOK PAGE 133 LINE 20