


STATE OF KANSAS
STATE CORPORATION COMMISSION

WELL PLUGGING RECORD

Give All Information Completely
Make Required Affidavit
Mail or Deliver Report to
Conservation Division
State Corporation Commission
211 No. Broadway
Wichita, Kansas

NORTH

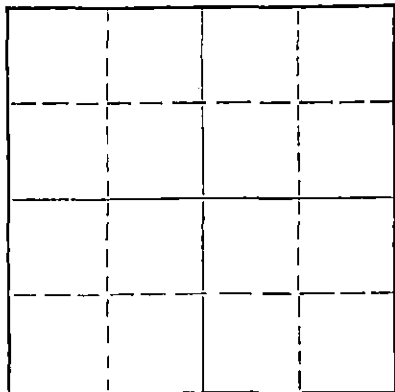

Locate well correctly on above
Section Plat

Rice County, Sec. 28 Twp. 20 Rge. (E) 7 (W)
Location as "NE/CNW/SE" or footage from lines App. C W/2 SE NE
Lease Owner ~~XXXXXXXXXXXX~~ Murfin Drilling Company
Lease Name England Well No. 5
Office Address 617 Union Center - Wichita, Kansas
Character of Well (completed as Oil, Gas or Dry Hole) Oil
Date well completed 8-25-58 19
Application for plugging filed 11-4-65 19
Application for plugging approved 11-4-65 19
Plugging commenced Dec 15 12-15-65 19 65
Plugging completed _____ 19
Reason for abandonment of well or producing formation Kansas City

If a producing well is abandoned, date of last production Apr. 1965 19
Was permission obtained from the Conservation Division or its agents before plugging was commenced? Yes

Name of Conservation Agent who supervised plugging of this well Gilbert Toman
Producing formation _____ Depth to top _____ Bottom _____ Total Depth of Well 3349 Feet
Show depth and thickness of all water, oil and gas formations.

OIL, GAS OR WATER RECORDS

CASING RECORD

FORMATION	CONTENT	FROM	TO	SIZE	PUT IN	PULLED OUT

Describe in detail the manner in which the well was plugged, indicating where the mud fluid was placed and the method or methods used in introducing it into the hole. If cement or other plugs were used, state the character of same and depth placed, from _____ feet to _____ feet for each plug set.

Filled back in the 5 1/2 and dumped 5 sacks of cement. Shot pipe off at 2910.90'.
Pulled pipe and mudded hole to 200'. Set rock bridge and finished filling surface with ready-mix cement.

RECEIVED
STATE CORPORATION COMMISSION
MAR 14 1966
CONSERVATION DIVISION
Wichita, Kansas

Name of Plugging Contractor Bert Self
Address Hutchinson, Kans.

STATE OF Kans. COUNTY OF Reno, ss.
Employee (employee of owner) or (owner or operator) of the above-described well, being first duly sworn on oath, says: That I have knowledge of the facts, statements, and matters herein contained and the log of the above-described well as filed and that the same are true and correct. So help me God.

(Signature) Bert Self
R. R. #4, Hutchinson, Kans.
(Address)

SUBSCRIBED AND SWORN to before me this 16th day of December, 19 65

My commission expires October 15, 1965 Notary Public.

CHERRY DRILLING CO., INC.
102 INSURANCE BUILDING
WICHITA 2, KANSAS

ROTARY DRILLING LOG

Lease: Engelland	Company: Murfin Drilling Company and H. C. Bennett Union Center Wichita, Kansas
Well No.: 5	
Location: C W/2 SE NE Section 28-208-7W Rice County, Kansas	Contractor: Cherry Drilling Co., Inc. 102 Insurance Building Wichita 2, Kansas
Elevation: 1645 D.F. 1642 Gr.	Geologist: W. P. Simmons 1801 Porter Wichita, Kansas
Well Commenced: 8-16-58	
Well Completed: 8-25-58	Surface Pipe: 8 Jts. used 8-5/8", 28#, 227.34' overall less thds. cemented w/ 165 sacks, 2%CC
	Casing: 112 Jts. new 5-1/2" 3356.61' overall less thds. cemented w/ 75 sacks common cement at 3347'

RECEIVED
STATE OF KANSAS

JAN 7 1966

0 - 227 Shale	2430 - 2604 Lime
227 - 480 Shale & red bed	2604 - 2860 Lime sand
480 - 1085 Shale, shells, anhydrite	2860 - 2874 Shale & sand
1085 - 1125 Anhydrite & shale	2874 - 2886 Brown Lime
1125 - 1675 Lime & shale	2886 - 2901 Shale & Lime
1675 - 1825 Lime	2901 - 3310 Lime
1825 - 2025 Shale & Lime	3310 - 3349 Shale & Conglomerate
2025 - 2430 Lime & Shale	3349 R. T. D.

GEOLOGIST'S TOPS

Heebner	2718 (-1070)	Lansing	2901 (-1253)
Toronto	2737 (-1089)	Base of Kansas City	3246 (-1598)
Douglas	2746 (-1098)	Conglomerate	3344 (-1696)
Brown Lime	2874 (-1226)	R. T. D.	3349 (-1701)

The above is a true and correct log to the best of my knowledge.

P. Betty Prault
Assistant Secretary

Subscribed and sworn to before me this 27th day of August, 1958.

Donna C. Sisk
Donna C. Sisk Notary Public

My Commission Expires: September 5, 1960.