


STATE OF KANSAS
STATE CORPORATION COMMISSION

Give All Information Completely
Make Required Affidavit
Mail or Deliver Report to:
Conservation Division
State Corporation Commission
211 No. Broadway
Wichita, Kansas

WELL PLUGGING RECORD

NORTH

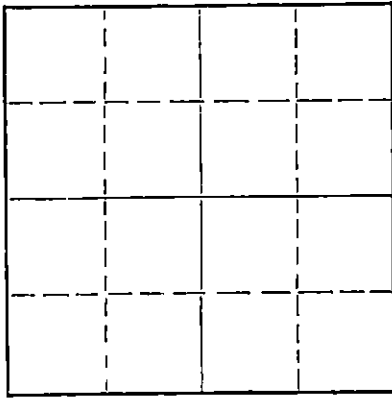

Locate well correctly on above
Section Plat

Rice County, Sec. 28 Twp 20 Rge. (E) 7 (W)
Location as "NE/CNW/SW" or footage from lines NE NE NE
Lease Owner Murfin Drilling Company
Lease Name Engelland Well No. 2
Office Address 617 Union Center = Wichita, Kansas
Character of Well (completed as Oil, Gas or Dry Hole) Oil
Date well completed Sept. 1956 19
Application for plugging filed 11-4-65 19
Application for plugging approved 11-4-65 19
Plugging commenced 12-16-65 19
Plugging completed 12-16-65 19
Reason for abandonment of well or producing formation Conglomerate

If a producing well is abandoned, date of last production Nov. 19 65
Was permission obtained from the Conservation Division or its agents before plugging was commenced? yes

Name of Conservation Agent who supervised plugging of this well Gilbert Toman
Producing formation _____ Depth to top _____ Bottom _____ Total Depth of Well 3373 Feet
Show depth and thickness of all water, oil and gas formations.

OIL, GAS OR WATER RECORDS

CASING RECORD

FORMATION	CONTENT	FROM	TO	SIZE	PUT IN	PULLED OUT

Describe in detail the manner in which the well was plugged, indicating where the mud fluid was placed and the method or methods used in introducing it into the hole. If cement or other plugs were used, state the character of same and depth placed, from _____ feet to _____ feet for each plug set.

Filled back in the 5 1/2 and dumped 5 sacks of cement. Shot pipe off at 2872.80'.

Pulled pipe and mudded hole to 200'. Set rock bridge and finished filling surface with ready-mix cement

RECEIVED
STATE CORPORATION COMMISSION
MAR 14 1966
CONSERVATION DIVISION
Wichita, Kansas

(If additional description is necessary, use BACK of this sheet)
Name of Plugging Contractor Bert Self
Address Hutchinson, Kansas

STATE OF Kansas, COUNTY OF Sedgwick, ss.
Operator _____ (employee of owner) or (owner or operator) of the above-described well, being first duly sworn on oath, says: That I have knowledge of the facts, statements, and matters herein contained and the log of the above-described well as filed and that the same are true and correct. So help me God.

(Signature) W. R. Murfin
W. R. Murfin - 617 Union Center-Wichita, Ks.
(Address)

SUBSCRIBED AND SWORN TO before me this 11th day of March, 19 66

My commission expires ADELA MIZENER, Notary Public
My commission expires November 5, 1966
Adela Mizener
Notary Public.

Bennett & Gould
Engelland #2

Contractor: Francis M. Raymond

NE NE NE, 28-20S-7W
Rice County, Kansas

Elev: 1640 GL
1645 KB

Comm: 9/1/56
Comp: 9/18/56

Casing" 8-5/8" @ 194'
5-1/2" @ 3351'

Cemented: 175 ex., 2 CC
75 ex.

CORRECTED LOG
Figures Indicate Bottom of Formation

FORMATION	DEPTH
Surface soil & sand	60
Shale & shells	105
Shale-Shells	192
Shale-salt & shells	1015
Lime & shale	1505
Shale & lime	2745
Sand-lime-shale	2880
Lime	2975
Lime & sand	3080
Lime & shale	3155
Lime	3180
Lime & shale	3305
Lime	3352
Tops: Heebner	2715
Douglas	2741
Brown Lime	2873
Lansing-Kansas City	2899
Base Kansas City	3243
Shaley Conglomerate	3336
Cherty Conglomerate	3350
Rotary Total Depth	3352

STATE OF KANSAS)
) ss
COUNTY OF SEDGWICK)

I hereby certify that the above information is true and correct to the best of my knowledge.

Chas W Raymond

Subscribed and sworn to before me this 19th day of November, 1956/

Walter D. Summers
Notary Public

My Commission Expires: 7/8/57

RECEIVED
STATE CORPORATION COMMISSION

JAN 7 1966
CONSERVATION DIVISION
Wichita, Kansas