


Bob Frensblys  
Geol Rept gives  
SE4 - (SW4 = "beal")

WELL PLUGGING RECORD

Give All Information Completely  
Make Required Affidavit  
Mail or Deliver Report to:  
Conservation Division  
State Corporation Commission  
211 No. Broadway  
Wichita, Kansas

Rice County. Sec 28 Twp. 20 Rge. 7 (E) (W)  
Location as "NE/CNW/SW" or footage from lines Nw/ Ne/ SW SE  
Lease Owner Bennet and Gould  
Lease Name Wagerle Well No. I  
Office Address 5828 N. Broadway, Wichita, Kansas.  
Character of Well (completed as Oil, Gas or Dry Hole) oil  
Date well completed \_\_\_\_\_ 19\_\_\_\_  
Application for plugging filed 6/17/59 19\_\_\_\_  
Application for plugging approved 7/1/59 19\_\_\_\_  
Plugging commenced 7/1/59  
Plugging completed 7/7 19\_\_\_\_  
Reason for abandonment of well or producing formation Went dry.

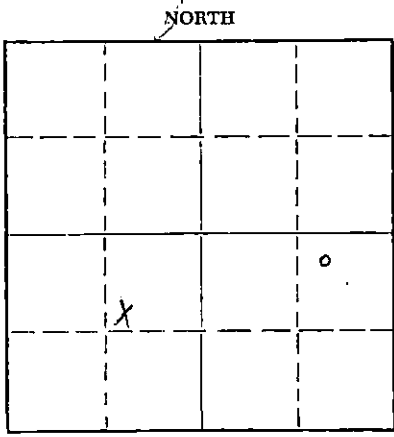

Locate well correctly on above Section Plat

If a producing well is abandoned, date of last production \_\_\_\_\_ 19\_\_\_\_  
Was permission obtained from the Conservation Division or its agents before plugging was commenced? yes.

Name of Conservation Agent who supervised plugging of this well Gilbert Toman  
Producing formation Conglomerate Depth to top 3353 Bottom 3364 Total Depth of Well 3364 Feet  
Show depth and thickness of all water, oil and gas formations.

OIL, GAS OR WATER RECORDS				CASING RECORD		
FORMATION	CONTENT	FROM	TO	SIZE	PUT IN	PULLED OUT
				5 1/2	3353	2850

Describe in detail the manner in which the well was plugged, indicating where the mud fluid was placed and the method or methods used in introducing it into the hole. If cement or other plugs were used, state the character of same and depth placed, from \_\_\_\_\_ feet to \_\_\_\_\_ feet for each plug set.

Plugged bottom of hole with rock. Rock bridge from 3364 to 3340 ft. Dumped 5 sx. of cement. Pulled out 5 1/2 pipe. Mudded hole to 200 ft. Then made 10 ft of rock bridge. Dumped 20 sx. cement at 190 ft. Made 10 ft. of rock, at 40 ft. Dumped 10 sx. of cement on top of rock. Well complete.

RECEIVED  
STATE CORPORATION COMMISSION  
NOV 4 1959  
CONSERVATION DIVISION  
Wichita, Kansas

(If additional description is necessary, use BACK of this sheet)  
Name of Plugging Contractor Art Lamb Casing Pulling Co.  
Address 310 S. Williams.

STATE OF Kansas, COUNTY OF Sedgwick, ss.  
\_\_\_\_\_  
(employee of owner) or (owner or operator) of the above-described well, being first duly sworn on oath, says: That I have knowledge of the facts, statements, and matters herein contained and the log of the above-described well as filed and that the same are true and correct. So help me God.

(Signature) H. Brant  
1212 Union Nat. Bldg. Wichita 2, Kas.  
(Address)

SUBSCRIBED AND SWORN TO before me this 3rd day of November, 19 59

My commission expires May 11, 1961  
H. M. Parkerson Notary Public.



R

ROTARY DRILLING LOG

Lease: Wagerle

Company: Bennett & Gould  
1214 Union National Building

Well: #1

Contractor: Salina Drilling Corp., Inc.  
102 Insurance Building, Wichita

Location: NW NE <sup>SE</sup> SW  
Sec. 28-T20S-27W  
Rice Co., Kansas

Geologist: Robert W. Frensley  
Insurance Building, Wichita, Kansas

Elevation: 1640 D. F.

Surface Pipe: 200' 12" 8 5/8 Surface Pipe  
201-98 Overall Lens Threads  
Cemented with 165 Sacks  
Reg. Cement 2% C. C.

Well Commenced: 9-23-56

Well Completed 10-2-56

Casing: 3360' 12" overall less threads  
Set Pipe @ 3356' 8' off bottom  
50 Sacks Reg. Cement  
One plug @ 3336'

\* \* \* \* \*

0-200 Sand, Redbed shale, shells	2335-2420	Line and Sand
	2420-2830	Line
200-635 Redbed and shale and shells	2830-2875	Line, sand, shale
635-1100 Shale, shells	2875-3364	Line
1100-1565 Shale		
1565-1810 Shale, shells		
1810-2060 Shale and lime, shells		
2060-2335 Lime, shale		

\* \* \* \* \*

GEOLOGIST'S TOPS

Heebner	2721
Toronto	2739
Douglas	2744
Brown Lime	2875
Lansing	2902
Base K. C.	3254
Cherty Congl.	3354
R. T. D.	3364

\* \* \* \* \*

**RECEIVED**  
STATE CORPORATION COMMISSION  
NOV 4 1959  
CONSERVATION DIVISION  
Wichita, Kansas

The above is a true and correct log to the best of my knowledge.

Subscribed and sworn to before me on this \_\_\_\_\_ day of October, 1956.

My Commission Expires: \_\_\_\_\_

Notary Public