


STATE OF KANSAS  
STATE CORPORATION COMMISSION

Give All Information Completely  
Make Required Affidavit  
Mail or Deliver Report to:  
Conservation Division  
State Corporation Commission  
211 No. Broadway  
Wichita, Kansas

WELL PLUGGING RECORD

Rice County, Sec. 29 Twp. 20S Rge. 7 (E) W (W)

Location as "NE/CNW/SW" or footage from lines NE NE SW  
Lease Owner Raymond Oil Company, Inc.  
Lease Name Lamberson Well No. 1  
Office Address 410 Fourth National Bank Building, Wichita 2, Kansas  
Character of Well (completed as Oil, Gas or Dry Hole) Oil Well  
Date well completed September 15 19 57  
Application for plugging filed December 26 19 63  
Application for plugging approved December 27 19 63  
Plugging commenced Dec. 31 19 63  
Plugging completed Jan. 6 19 64  
Reason for abandonment of well or producing formation Production too low

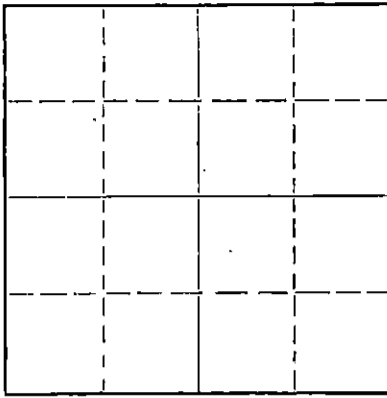

Locate well correctly on above Section Plat

If a producing well is abandoned, date of last production January 1 19 63  
Was permission obtained from the Conservation Division or its agents before plugging was commenced? Yes

Name of Conservation Agent who supervised plugging of this well Gilbert Loman  
Producing formation \_\_\_\_\_ Depth to top \_\_\_\_\_ Bottom 3315' Total Depth of Well 3315 Feet  
Show depth and thickness of all water, oil and gas formations.

OIL, GAS OR WATER RECORDS

CASING RECORD

FORMATION	CONTENT	FROM	TO	SIZE	PUT IN	PULLED OUT
				8 5/8	229'	
				5 1/2"	3310'	

Describe in detail the manner in which the well was plugged, indicating where the mud fluid was placed and the method or methods used in introducing it into the hole. If cement or other plugs were used, state the character of same and depth placed, from \_\_\_\_\_ feet to \_\_\_\_\_ feet for each plug set.

Fitted back with gravel and dumped 5 sacks of cement. Shot pipe off at 2974'.  
Pulled pipe and mudded hole to 200'. Set rock bridge and dumped 20 sacks of cement. Finished mudding hole to 35' and dumped 10 sacks of cement at base of cellar.


RECEIVED  
STATE CORPORATION COMMISSION  
JAN 10 1964  
CONSERVATION DIVISION  
Wichita, Kansas  
1-10-1964

Name of Plugging Contractor Bert Self Casing Pulling Company  
Address Rural Route #4, Hutchinson, Kansas

STATE OF Kans, COUNTY OF Reno, ss.  
(employee of owner) or (owner or operator) of the above-described well, being first duly sworn on oath, says: That I have knowledge of the facts, statements, and matters herein contained and the log of the above-described well as filed and that the same are true and correct. So help me God.

(Signature) Bert Self  
R. R. #4, Hutchinson, Kans.  
(Address)

SUBSCRIBED AND SWORN to before me this 7th day of January, 19 64  
Dorothy Self  
Notary Public.  
My commission expires October 18, 1965

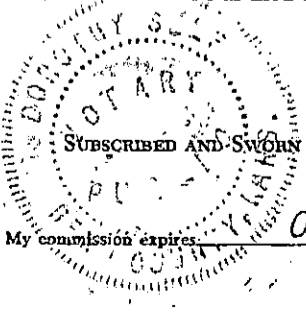

RAYMOND #1 LAMBERSON  
 NE NE SW, 29-20S-7W  
 Rice County, Kansas

Contractor: Raymond Oil Co., Inc.  
 Elevation: 1633 KB  
 1630 DF  
 1626 GL

Comm: 9/8/57  
 Comp: 9/15/57 (Rotary)

Casing: 8-5/8" @ 229'  
 5-1/2" @ 3310'

Cement: 200 sx, 2% CC  
 50 sx.

Figures Indicate Bottom of Formation

<u>Formation</u>	<u>Depth</u>
Surface Hole	229
Shale, Shells & Salt	1065
Shale & Shells	1300
Lime & Shale w/Sand	1535
Shale & Lime	1745
Shale & Shells	2175
Shale & Lime	2300
Lime & Shale	2390
Lime w/Shale	2715
Sand & Lime & Shale	2805
Shale & Sand	2854
Lime and Shale	3307
Chert	3315
Tops:	
Heebner	2700
Toronto	2718
Douglas	2730
Brown Lime	2853
Lansing	2882
Base Kansas City	3216
Cherty Conglomerate	3297
Rotary Total Depth	3315

RECEIVED  
 STATE CORPORATION COMMISSION

DEC 27 1963

CONSERVATION DIVISION  
 Wichita, Kansas

STATE OF KANSAS )  
 ) SS  
 COUNTY OF SEDGWICK )

I hereby certify that the above information is true and correct to the best of my knowledge.

*Chas. W. Raymond*  
 Chas. W. Raymond

Subscribed and sworn to before me this 18th day of September, 1957.

*Betty Baker*  
 Notary Public

My Commission Expires: 2/24/60