


WELL PLUGGING RECORD

Give All Information Completely  
Make Required Affidavit  
Mail or Deliver Report to:  
Conservation Division  
State Corporation Commission  
800 Bittling Building  
Wichita, Kansas

Rice County. Sec. 30 Twp. 20S Rge. 7W (E) (W)  
Location as "NE/CNW $\frac{1}{4}$ /SW $\frac{1}{4}$ " or footage from lines SW SW SW  
Lease Owner K & E Drilling, Inc.  
Lease Name JONES Well No. 1  
Office Address 1006 Central Bldg., Wichita, Kansas  
Character of Well (completed as Oil, Gas or Dry Hole) Dry Hole  
Date well completed 11-27 19.51  
Application for plugging filed 12-18 19.51  
Application for plugging approved 12-18 19.51  
Plugging commenced 12-19 19.51  
Plugging completed 12-27 19.51  
Reason for abandonment of well or producing formation Commercial quantity of oil not found.  
If a producing well is abandoned, date of last production 19.  
Was permission obtained from the Conservation Division or its agents before plugging was commenced? Yes

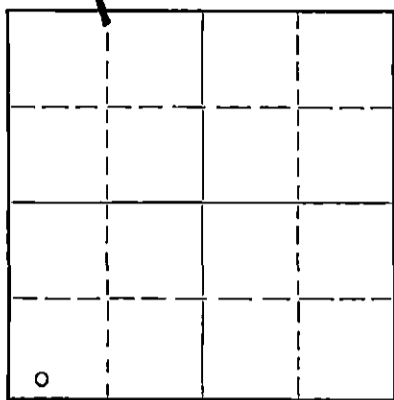

Locate well correctly on above Section Plat

Name of Conservation Agent who supervised plugging of this well Ruel Durkee, McPherson, Kansas  
Producing formation Depth to top Bottom Total Depth of Well 3350 Feet  
Show depth and thickness of all water, oil and gas formations.

OIL, GAS OR WATER RECORDS

CASING RECORD

Formation	Content	From	To	Size	Put In	Pulled Out
				8 5/8	142	None
				5 1/2	3334	2800

Describe in detail the manner in which the well was plugged, indicating where the mud fluid was placed and the method or methods used in introducing it into the hole. If cement or other plugs were used, state the character of same and depth placed, from.....feet to.....feet for each plug set.

Plugged hole back with sand from T.D. 3350 to 3305'. Dumped 6 sacks cement. Shot casing off at 2800'. Pulled out pipe. Filled hole with heavy mud to 350'. Set permanent bridge. Dumped 15 sacks cement, filled hole with mud to 30'. Mixed cap on well. Work completed 12.27-51.

RECEIVED  
DIVISION  
JAN 18 1952  
1-18-1952

(If additional description is necessary, use BACK of this sheet)  
Correspondence regarding this well should be addressed to K & E Drilling, Inc.  
Address 1006 Central Bldg., Wichita, Kansas

STATE OF KANSAS, COUNTY OF SEDGWICK, ss.  
Clinton Engstrand (employee of owner) or (owner or operator) of the above-described well, being first duly sworn on oath, says: That I have knowledge of the facts, statements, and matters herein contained and the log of the above-described well as filed and that the same are true and correct. So help me God.  
(Signature) *Clinton Engstrand*  
1006 Central Bldg., Wichita, Kansas (Address)

SUBSCRIBED AND SWORN TO before me this 17th day of January, 19.52

*Joe Paul*  
Notary Public.

My commission expires 12-19-55

FILE 30-30-120-R-744  
BOOK PAGE 134 LINE 15

K & E DRILLING, INC.  
 JONES #1

SW SW SW Sec. 30-20S-7W  
 Rice County, Kansas

Comm: 11-18-51  
 Comp: 11-27-51  
 Total Depth: 3350'

<u>Casing</u>	<u>Cement</u>
8 5/8 Set @ 142	100 Sacks
5 1/2 - <del>None</del> 23090304	125 "

<u>FORMATION</u>	<u>DEPTH</u>
Surface clay & sand	0 - 15
Sand & gravel	15 - 62
Shale & red rock	62 - 142
Red bed & shells	142 - 305
Anhydrite	305 - 330
Shale & shells, salt	330 - 730
Shale & shells	730 - 1350
Lime	1350 - 1495
Shale & shells	1495 - 2195
Shale	2195 - 2450
Lime & shale	2450 - 2530
Shale & shells	2530 - 2784
Shale & lime	2784 - 2920
Shale & shells	2920 - 2979
Shale & lime	2979 - 3194
Lime	3194 - 3239
Lime & shale	3239 - 3317
Shale	3317 - 3350

STATE OF KANSAS )  
 ) SS  
 SEDGWICK COUNTY )

I hereby certify that the above information is true and correct to the best of my knowledge.

JAN 18 1952

Subscribed and sworn to before me this 21<sup>st</sup> day of December, 1951.

*[Handwritten Signature]*

*[Handwritten Signature]*  
 Notary Public

My Commission Expires: 6-5-54

30-20S-7W  
 PAGE 134 LINE 5