


WELL PLUGGING RECORD

Give All Information Completely
Make Required Affidavit
Mail or Deliver Report to:
Conservation Division
State Corporation Commission
211 No. Broadway
Wichita, Kansas

Rice County. Sec. 27 Twp 20S Rge. 7 (E) (W)

Location as "NE/CNW/SW" or footage from lines NW NW NW
Lease Owner Raymond Oil Company, Inc.
Lease Name A. V. Engelland Well No. B 1
Office Address 410 Fourth National Bank Bldg., Wichita, Kansas
Character of Well (completed as Oil, Gas or Dry Hole) Oil
Date well completed January 28 19 57
Application for plugging filed November 5, 19 59
Application for plugging approved Nov. 6 19 59
November 23 19 59
Plugging commenced November 27 19 59
Plugging completed Nov. 10 19 59
Reason for abandonment of well or producing formation no longer commercially productive
If a producing well is abandoned, date of last production October 10 19 59
Was permission obtained from the Conservation Division or its agents before plugging was commenced? Yes

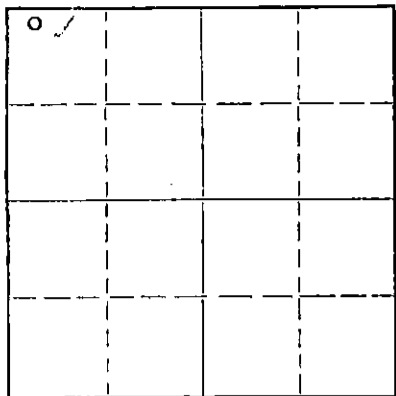

Locate well correctly on above Section Plat

Name of Conservation Agent who supervised plugging of this well G. Toman
Producing formation Conglomerate Depth to top 3355 Bottom 3367 Total Depth of Well 3367 Feet
Show depth and thickness of all water, oil and gas formations.

OIL, GAS OR WATER RECORDS

CASING RECORD

FORMATION	CONTENT	FROM	TO	SIZE	PUT IN	PULLED OUT

Describe in detail the manner in which the well was plugged, indicating where the mud fluid was placed and the method or methods used in introducing it into the hole. If cement or other plugs were used, state the character of same and depth placed, from _____ feet to _____ feet for each plug set.

Sanded back to 3340'. Dumped 5 sacks of cement. Shot pipe off at 3025'. Pulled pipe and mudded hole to 205'. Set rock bridge to 195'. Dumped 20 sacks of cement. Finished mudding hole and capped surface pipe with 10 sacks of cement.

STATE CORPORATION COMMISSION
JAN 22 1960
CONSERVATION DIVISION
Wichita, Kansas

Name of Plugging Contractor Bert Self (If additional description is necessary, use BACK of this sheet)
Address RR #4, Hutchinson, Kansas

STATE OF Kans. COUNTY OF reno, ss. Employee (employee of owner) or (owner or operator) of the above-described well, being first duly sworn on oath, says: That I have knowledge of the facts, statements, and matters herein contained and the log of the above-described well as filed and that the same are true and correct. So help me God.

(Signature) Bert Self
R. R. #4, Hutchinson, Kans.
(Address)

SUBSCRIBED AND SWORN TO before me this 28th day of November, 19 59

My commission expires August 12, 1961
Dorothy Self Notary Public.

*Recorded
m.s.*

RAYMOND OIL COMPANY, INC.
#1 A. V. ENGELLAND "B"
NW NW NW, 27-208-7W
RICE COUNTY, KANSAS

Contractor:
 Raymond Oil Company, Inc.

Comm: 1/8/57
 Comp: 1/15/57

33 1/2" 1130 RB
 1547 DP - oct.
 145 3L
 175 3L, 2 CC
 50 3L

Casing: 8-5/8" @ 205.64'
 5-1/2" @ 3356'

Figures indicate location of formation

<u>Formation</u>	Depth
Surface Hole	200
Shale, Red Bed, Shells	700
Shale, Shells & Lime	1285
Lime & Shale	1350
Sandy Lime	1380
Lime with Shale	1680
Lime & Shale	1890
Shale with Shells	2410
Lime plus Shale	2465
Lime & Shale	2725
Lime with shale	3769
Sandy Shale plus Lime	3835
Lime & Shale	3965
Lime	3233
Lime and Shale	3910
Lime plus Shale	3358
Topo: Heekner	2719
Douglas	3743
Brown Lime	2878
Lansing-Kansas City	2902
Base Kansas City	3248
Shaley Conglomerate	3342
Cherty Conglomerate	3358
Rotary Total Depth	3998

STATE OF KANSAS)
) ss
 COUNTY OF SEDGWICK)

I hereby certify that the above information is true and correct to the best of my knowledge.

Subscribed and sworn to before me this _____ day of January, 1957.

My Commission Expires 7/8/57

Notary Public