


Give All Information Completely
Make Required Affidavit
Mail or Deliver Report to:
Conservation Division
State Corporation Commission
211 No. Broadway
Wichita, Kansas

WELL PLUGGING RECORD

Rice County, Sec. 21 Twp. 20S Rge. (E) 7 (W)

Location as "NE/CNW%SW%" or footage from lines _____
Lease Owner Raymond Oil Co., Inc.
Lease Name E. Baker Well No. 1
Office Address 410 Fourth National Bank Bldg., Wichita 2, Kansas
Character of Well (completed as Oil, Gas or Dry Hole) Oil
Date well completed May 14 19 57
Application for plugging filed November 5 19 59
Application for plugging approved November 6 19 59
Plugging commenced Nov. 28 19 59
Dec. 3 19 59
Plugging completed _____ 19 _____
Reason for abandonment of well or producing formation no longer commercially productive

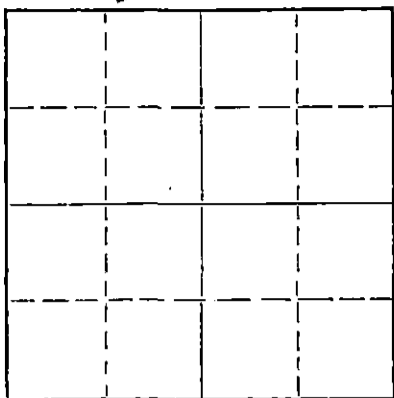

Locate well correctly on above Section Plat

If a producing well is abandoned, date of last production October 10 19 59

Was permission obtained from the Conservation Division or its agents before plugging was commenced? Yes

Name of Conservation Agent who supervised plugging of this well G. Toman

Producing formation Conglomerate Depth to top _____ Bottom _____ Total Depth of Well 3390 Feet

Show depth and thickness of all water, oil and gas formations. PB 3370'

OIL, GAS OR WATER RECORDS

CASING RECORD

FORMATION	CONTENT	FROM	TO	SIZE	PUT IN	PULLED OUT

Describe in detail the manner in which the well was plugged, indicating where the mud fluid was placed and the method or methods used in introducing it into the hole. If cement or other plugs were used, state the character of same and depth placed, from _____ feet to _____ feet for each plug set.

Sanded back to 3330'. Dumped 5 sacks of cement. Shot pipe off at 2896'. Pulled pipe and mudded hole to 200'. Set 10' rock bridge and dumped 20 sacks of cement. Finished mudding hole and dumped 10 sacks of cement in top of surface.

RECEIVED
STATE CORPORATION COMMISSION
APR 5 1963

Name of Plugging Contractor Bert Self
Address RR #4, Hutchinson, Kansas

STATE OF Kans. COUNTY OF Reno, ss. Employee (employee of owner) or (owner or operator) of the above-described well, being first duly sworn on oath, says: That I have knowledge of the facts, statements, and matters herein contained and the log of the above-described well as filed and that the same are true and correct. So help me God.

(Signature) Bert Self
R. R. #4, Hutchinson, Kans.
(Address)

SUBSCRIBED AND SWORN TO before me this 8th day of December, 19 59

My commission expires August 12, 1961 Notary Public.

