

## DISTRICT CONSERVATION AGENT'S REPORT

TO:

State Corporation Commission  
Conservation Division  
800 Bitting Building  
Wichita, Kansas

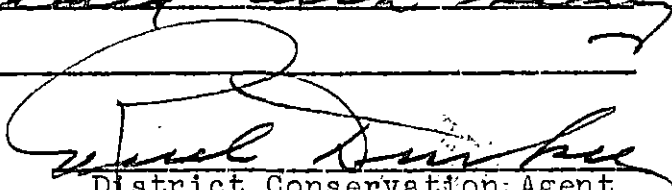
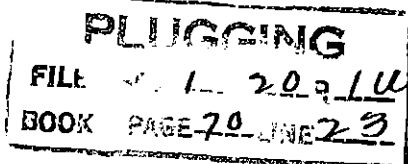
FILE NO. 70-23LOCATION 3W2 - NW - SESEC. 1 TWP. 20 RGE. 1WDry Hole            Abandoned Oil Well ✓ Abandoned Gas Well           

I have today completed supervision of plugging of:

Well No. 3 Lease YothOperator The Stellar Oil Corp Address Wichita, KansField Canton County McPhersonTotal Depth 2916 1/2 Feet.

(Describe briefly the manner in which the well was plugged)

6 sts of cement dumped at 2892 and  
hole made solid at 150' and 20 sts  
of cement dumped at 130 " 5 "  
" " at top of surface pipe.  
The intervals between above  
plugs were mudded with heavy  
mud.

  
District Conservation Agent
Date 11-4-46

11-5-46