


WELL PLUGGING RECORD

Give All Information Completely
Make Required Affidavit
Mail or Deliver Report to:
Conservation Division
State Corporation Commission
800 Biting Building
Wichita, Kansas

Mc Pherson County, Sec. _____ Twp. 21 Rge. 20 (#) 1 (W)
Location as "NE/CNW/SW" or footage from lines NW NW NW

Lease Owner M & L Oil Company
Lease Name Otte Well No. 1
Office Address Brown Bldg.

Character of Well (completed as Oil, Gas or Dry Hole) Dry Hole
Date well completed May 17 19 54
Application for plugging filed " 19
Application for plugging approved " 19
Plugging commenced " 19
Plugging completed " 19
Reason for abandonment of well or producing formation _____

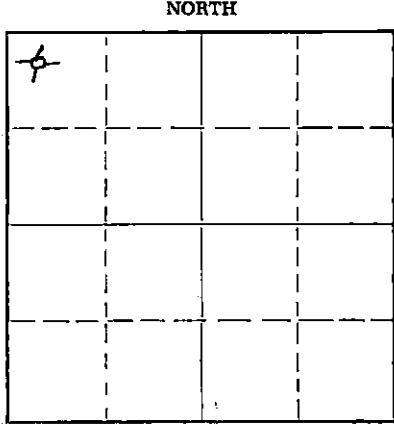

Locate well correctly on above Section Plat

If a producing well is abandoned, date of last production 19 _____
Was permission obtained from the Conservation Division or its agents before plugging was commenced? _____

Name of Conservation Agent who supervised plugging of this well Ruel Purke
Producing formation _____ Depth to top _____ Bottom _____ Total Depth of Well 390 1/2 Feet
Show depth and thickness of all water, oil and gas formations.

OIL, GAS OR WATER RECORDS

CASING RECORD

FORMATION	CONTENT	FROM	TO	SIZE	PUT IN	PULLED OUT
				8 5/8	161	none

Describe in detail the manner in which the well was plugged, indicating where the mud fluid was placed and the method or methods used in introducing it into the hole. If cement or other plugs were used, state the character of same and depth placed, from _____ feet to _____ feet for each plug set.

Filled hole with heavy mud to 160'.
Drove wooden plug and put in 15 sacks cement.
Drove wooden plug at 35' and put in 10 sacks cement.

RECEIVED
STATE CORPORATION COMMISSION
MAY 24 1954
CONSERVATION DIVISION
Wichita, Kansas
5-26-54

(If additional description is necessary, use BACK of this sheet)
Name of Plugging Contractor Mallard Drilling Company
Address 1016 Union National Bank Bldg.

STATE OF Kansas, COUNTY OF Sedgwick, ss.
G. C. Nelson, partner (owner or operator) of the above-described well, being first duly sworn on oath, says: That I have knowledge of the facts, statements, and matters herein contained and the log of the above-described well as filed and that the same are true and correct. So help me God.
(Signature) G. C. Nelson

SUBSCRIBED AND SWORN TO before me this 24th day of May, 1954
Stanwell Wright Notary Public.
My commission expires 12/4/56

24-2675-5 2-52-20M
PLUGGING
FILE SEC 21 T. 20 R. 16 W
BOOK PAGE 33 LINE 20

COMPANY: M & L Oil Company
 CONTRACTOR: Mallard Drilling Company
 FARM: Otte #1
 LOCATION: NW NW NW Sec. 21-20-1W
 Mc Pherson County, Kansas
 COMMENCED: May 10, 1954
 COMPLETED: May 17, 1954

0	to	23	Yellow clay
23	to	69	Sand
69	to	161	Blue shale
161	to	435	Shale and lime
435	to	1035	Lime
1035	to	1865	Shale and lime
1865	to	2130	Shale and lime
2130	to	2330	Shale and sand
2330	to	2335	Lime
2335	to	2620	Lime
2620	to	2785	Lime and shale
2785	to	2960	Lime and shale
2960	to	2970	Mississippi
2970	to	3000	Mississippi
3000	to	3004 $\frac{1}{2}$	Mississippi
		3004 $\frac{1}{2}$	T.D.

Set 161 feet of 8 5/8" surface pipe. Cemented with 100 sacks cement.

TOPS:

DRY, ABANDONED AND PLUGGED

Measurements taken from R.D.B. R.D.B. 5 $\frac{1}{2}$ ' from ground level.

RECEIVED
 STATE CORPORATION COMMISSION
 MAY 23 1954

C E R T I F I C A T E

I, C. C. Nelson, do hereby certify that the above and foregoing is a true and correct copy of log of the Otte #1, Mc Pherson County, Kansas, as reflected by files of the Mallard Drilling Company.

C. C. Nelson

Subscribed and sworn to before me a Notary Public, within and for Sedgwick County, Kansas, this 20th day of May 1954.

Harwell Wright

My commission expires 12/4/56

PLUGGING
 FILE SEC 21 T 20 R 1W
 BOOK PAGE 35 LINE 20