


STATE OF KANSAS
STATE CORPORATION COMMISSION

Give All Information Completely
Make Required Affidavit
Mail or Deliver Report to:
Conservation Division
State Corporation Commission
800 Bixing Building
Wichita, Kansas

WELL PLUGGING RECORD

McPherson County. Sec. 19 Twp. 20 S Rge. 11 W (E) (W)
Location as "NE/CNW/SW" or footage from lines NW SW NW
Lease Owner George R. Hess
Lease Name KL 377 Well No. 71
Office Address 505 N. Charles McPherson, Ks.
Character of Well (completed as Oil, Gas or Dry Hole) Dry
Date well completed June 17, 19 57
Application for plugging filed " " " " 19 57
Application for plugging approved " " " " 19 57
Plugging commenced " " " " 19 57
Plugging completed " " " " 19 57
Reason for abandonment of well or producing formation Dry

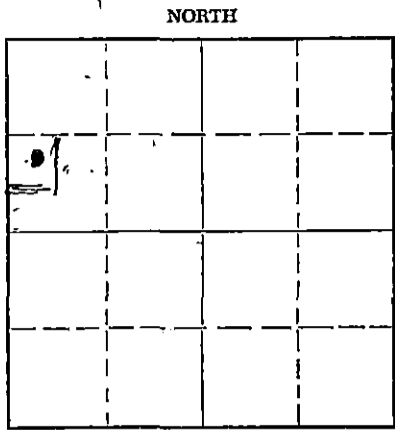

Locate well correctly on above Section Plat

If a producing well is abandoned, date of last production _____ 19 ____
Was permission obtained from the Conservation Division or its agents before plugging was commenced? Yes

Name of Conservation Agent who supervised plugging of this well Ruel Durkee
Producing formation CH 3T Depth to top 2985 Bottom 3012 Total Depth of Well 3012 Feet
Show depth and thickness of all water, oil and gas formations.

OIL, GAS OR WATER RECORDS

CASING RECORD

FORMATION	CONTENT	FROM	TO	SIZE	PUT IN	PULLED OUT
Surface Pipe	Cemented 100 sack			8 5/8	163	None

Describe in detail the manner in which the well was plugged, indicating where the mud fluid was placed and the method or methods used in introducing it into the hole. If cement or other plugs were used, state the character of same and depth placed, from _____ feet to _____ feet for each plug set.

Circulated on bottom for 1 hour
Mixed heavy mud
lay down 1500 ft. of drill pipe & circulate for 30 minutes
Pushed wooden plug to 160 feet
Boiled solid bridge of rock
Dumped 15 sac of mixed cement thru 5 ft of drill pipe
Guided surface pipe with heavy mud 20 ft
Pushed plug to 35 ft, mixed 5 sac of cement & filled to top

Surface pipe cut off 2 1/2 ft from top of ground
Location approx 100 ft. due NE of regular location
because of barn.

(If additional description is necessary, use BACK of this sheet)

Name of Plugging Contractor _____
Address _____

STATE OF Kansas COUNTY OF McPherson, ss.
George R. Hess (employee of owner) or (owner or operator) of the above-described well, being first duly sworn on oath, says: That I have knowledge of the facts, statements, and matters herein contained and the log of the above-described well as filed and that the same are true and correct. So help me God.

(Signature) George R Hess
(Address) _____

SUBSCRIBED AND SWORN to before me this 11 day of July, 19 57

My commission expires Jan 17, 1961 Corroll O. Winslow Notary Public.

PLUGGING
FILE SEC 19 T 20 R 1 W
BOOK PAGE 22 LINE 36

COMPANY: George Hess
 CONTRACTOR: Mallard Drilling Company
 FARM: Klatt #1
 LOCATION: ~~SE SW~~ NW Sec. 19-208-1W
 Mc Pherson, County, Kansas
 COMMENCED: June 11, 1957
 COMPLETE: June 17, 1957

0	to	163	Shale
163	to	590	Shale
590	to	785	Lime
785	to	995	Lime and shale
995	to	1420	Shale
1420	to	1690	Shale and lime
1690	to	1885	Lime and shale
1885	to	2020	Lime
2020	to	2190	Lime and shale
2190	to	2344	Shale and lime
2344	to	2550	Lime
2550	to	2660	Lime
2660	to	2880	Lime and shale
2880	to	2952	Lime and shale
2952	to	3012	Mississippi
		3012	T.D.

Set 163 ft. 8 5/8" surface pipe. Cemented with 100 sacks cement.

TOPS: Brown line -- 2273
 Kansas City -- 2344
 Chat -- 2985

DRY, ABANDONED AND PLUGGED

Measurements taken from R.D.B. R.D.B. 5 1/2' from ground level

C E R T I F I C A T E

I, C. C. Nelson, do hereby certify that the above and foregoing is a true and correct copy of log of the Klatt #1, Mc Pherson County, Kansas, as reflected by files of the Mallard Drilling Company.

C. C. Nelson

Subscribed and sworn to before me a Notary Public, within and for Sedgwick County, Kansas this 29th day of June 1957.

Robert A. Hurd

My commission expires 11-16-59

CONSERVATION DIVISION
 JUN 12 1957
 Wichita, Kansas

PLUGGING

FILE SEC. 19 T. 20 R. 1W
 BOOK PAGE 22 LINE 36