


WELL PLUGGING RECORD

Give All Information Completely  
Make Required Affidavit  
Mail or Deliver Report to:  
Conservation Division  
State Corporation Commission  
211 No. Broadway  
Wichita, Kansas

McPherson County, Sec. 29 Twp. 20S Rge. 1W (E) (W)

T 20S NORTH R 1W

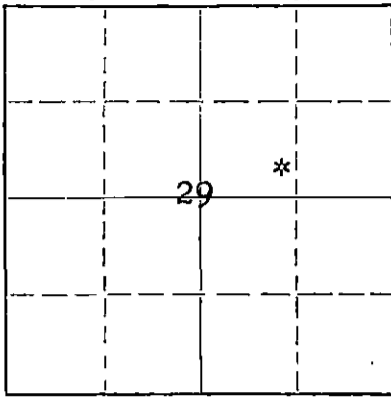

Locate well correctly on above Section Plat

Location as "NE/CNW\*SW\*" or footage from lines SE SE NE  
Lease Owner National Associated Petroleum Company  
Lease Name Jahn Well No. 1  
Office Address 502 Ritz Bldg. - Tulsa, Oklahoma  
Character of Well (completed as Oil, Gas or Dry Hole) \_\_\_\_\_  
Date well completed \_\_\_\_\_ 19\_\_\_\_  
Application for plugging filed \_\_\_\_\_ 19\_\_\_\_  
Application for plugging approved \_\_\_\_\_ 19\_\_\_\_  
Plugging commenced December 15 19 55  
Plugging completed December 23 19 55  
Reason for abandonment of well or producing formation \_\_\_\_\_

If a producing well is abandoned, date of last production \_\_\_\_\_ 19\_\_\_\_  
Was permission obtained from the Conservation Division or its agents before plugging was commenced? Yes

Name of Conservation Agent who supervised plugging of this well Ruel Durkee  
Producing formation \_\_\_\_\_ Depth to top \_\_\_\_\_ Bottom \_\_\_\_\_ Total Depth of Well 3600 Feet  
Show depth and thickness of all water, oil and gas formations.

OIL, GAS OR WATER RECORDS

CASING RECORD

FORMATION	CONTENT	FROM	TO	SIZE	PUT IN	PULLED OUT
				8-5/8"	160'	None
				5-1/2"	3550'	1993'
				Plug set a 3055' and pipe perforated from 3018' to 3022'.		

Describe in detail the manner in which the well was plugged, indicating where the mud fluid was placed and the method or methods used in introducing it into the hole. If cement or other plugs were used, state the character of same and depth placed, from \_\_\_\_\_ feet to \_\_\_\_\_ feet for each plug set.

Filled the hole with sand from 3055' to 2980' and ran 6 sacks of cement. Mudded the hole to 200', set a 10' rock bridge and ran 15 sacks of cement. Mudded the hole to 20', set a 5' rock bridge and ran 5 sacks of cement on top. Plugging completed.

RECEIVED  
STATE CORPORATION COMMISSION

JAN 4 1956

CONSERVATION DIVISION  
Wichita, Kansas

1-4-1956

Name of Plugging Contractor West Supply Co., Inc. (If additional description is necessary, use BACK of this sheet)  
Address Chase, Kansas

STATE OF Kansas COUNTY OF McPherson, ss.  
Lawrence O. Tenk, Jr. (employee of owner) or (owner or operator) of the above-described well, being first duly sworn on oath, says: That I have knowledge of the facts, statements, and matters herein contained and the log of the above-described well as filed and that the same are true and correct. So help me God.

(Signature) Lawrence O. Tenk, Jr.  
McPherson, Kansas (Address)

SUBSCRIBED AND SWORN to before me this 3rd day of January, 1956

Commission expires July 31, 1959

Jr. S. New  
Notary Public.

PLUGGING  
FILE SEC 29 T 20 R 1W  
BOOK PAGE 26 LINE 43