


Give All Information Completely
Make Required Affidavit
Mail or Deliver Report to:
Conservation Division
State Corporation Commission
P. O. Box 17027
Wichita, Kansas 67217
NORTH

WELL PLUGGING RECORD

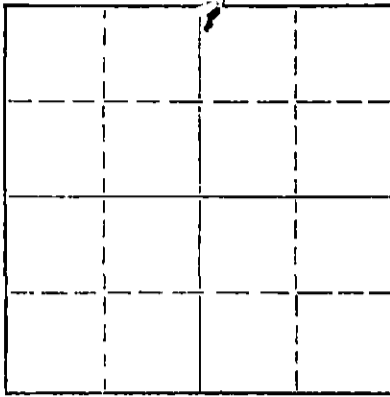

Locate well correctly on above Section Plat

McPherson County. Sec. 29 Twp. 20 Rge. 1 ~~XXX~~ (W)
Location as "NE/CNW/SW" or footage from lines NE SE SE
Lease Owner E. K. Loewen
Lease Name A. W. Boesker Well No. 1
Office Address Canton, Kansas 67428
Character of Well (completed as Oil, Gas or Dry Hole) Dry Hole
Date well completed October 5, 1974
Application for plugging filed 19
Application for plugging approved 19
Plugging commenced 19
Plugging completed October 5, 1974
Reason for abandonment of well or producing formation Dry Hole

If a producing well is abandoned, date of last production 19
Was permission obtained from the Conservation Division or its agents before plugging was commenced? Yes

Name of Conservation Agent who supervised plugging of this well Hugh Scott, McPherson, Ks.
Producing formation _____ Depth to top _____ Bottom _____ Total Depth of Well _____ Feet
Show depth and thickness of all water, oil and gas formations.

OIL, GAS OR WATER RECORDS

CASING RECORD

| FORMATION | CONTENT | FROM | TO | SIZE | PUT IN | PULLED OUT |
|-----------|---------|------|-----|--------|--------|------------|
| Clay | | 0 | 65 | 8 5/8" | 65' | None |
| Sand | | 65 | 80 | 8 5/8" | 15' | None |
| Shale | | 80 | 151 | 8 5/8" | 71' | None |
| | | | | | | |
| | | | | | | |
| | | | | | | |

Describe in detail the manner in which the well was plugged, indicating where the mud fluid was placed and the method or methods used in introducing it into the hole. If cement or other plugs were used, state the character of same and depth placed, from _____ feet to _____ feet for each plug set.

Plug hole at 160 ft. Put in 25 sacks cement and filled hole with mud to 40' and put in 10 sacks cement. 2 sacks in rat hole. Job completed at 6:30 A. M. October 5, 1974. Plugging completed by State Plugger, Hugh Scott, McPherson, Kansas

RECEIVED
STATE CORPORATION COMMISSION
OCT 22 1974
CONSERVATION DIVISION
Wichita, Kansas

(If additional description is necessary, use BACK of this sheet)
Name of Plugging Contractor Blackstone Drilling, Inc.
Address Box 455, McPherson, Kansas 67460

STATE OF Kansas, COUNTY OF McPherson, ss.
E. K. Loewen ~~XXXXXXXXXXXX~~ (owner or operator) of the above-described well, being first duly sworn on oath, says: That I have knowledge of the facts, statements, and matters herein contained and the log of the above-described well as filed and that the same are true and correct. So help me God.

(Signature) E. K. Loewen
Canton, Kansas 67428
(Address)

SUBSCRIBED AND SWORN TO before me this 21 day of October, 1974

My commission expires Sept 30, 1975
Sam Bolin Notary Public
RICE COUNTY, KANSAS
My Commission Expires
September 30, 1975
Notary Public.



Blackstone Drilling, Inc.

Box 455 • 523 West Kansas • Phone (316) 241-1250

McPHERSON, KANSAS 67460

October 7, 1974

COMPANY: E. K. LOEWEN
 CONTRACTOR: BLACKSTONE DRILLING, INC.
 FARM: A. W. BOESKER #1
 LOCATION: NE/4 SE/4 SE/4, Sec. 29-20S-1W, McPherson County, Kansas
 COMMENCED: September 28, 1974
 COMPLETED: October 5, 1974
 ELEVATION: 1538 K. B.

| | | | |
|------|----|------|--------------|
| 0 | to | 65 | Clay |
| 65 | to | 80 | Sand |
| 80 | to | 151 | Shale |
| 151 | to | 400 | Lime |
| 400 | to | 655 | Lime & Shale |
| 655 | to | 880 | Lime |
| 880 | to | 1110 | Lime & Shale |
| 1110 | to | 1590 | Shale & Lime |
| 1590 | to | 1670 | Lime & Shale |
| 1670 | to | 2090 | Lime |
| 2090 | to | 2365 | Lime & Shale |
| 2365 | to | 2750 | Lime |
| 2750 | to | 2865 | Lime & Shale |
| 2865 | to | 2925 | Shale & Lime |
| 2925 | to | 2951 | Shale |
| 2951 | to | 3022 | Mississippi |
| | | 3022 | T. D. |

RECEIVED
 STATE CORPORATION COMMISSION
 OCT 22 1974
 CONSERVATION DIVISION
 Wichita, Kansas

Cut 12 1/4 inch hole to 151' and run 153' of 3 5/8 inch surface pipe, cemented with 125 sacks of cement at 151', plug down at 1:00 P. M., September 28, 1974. Cut 7 7/8 " to 3022'. Hole dry and abandoned. Plug hole at 160' and put in 25 sacks of cement. Filled hole with mud to 40' and put in 10 sacks of cement. 2 sacks in rat hole. Plugging completed at 6:30 A. M., October 5, 1974. Plugging completed by Hugh Scott, State Plugger, McPherson, Kansas.

TOPS: MISSISSIPPI - 2951'

Measurements taken from K. B.

CERTIFICATE

I, P. E. Plouffe, President of Blackstone Drilling, Inc. do hereby certify that the above and foregoing is a true and correct copy of log on your A. W. Boesker, #1 located on the NE/4 SE/4 SE/4, Section 29-20S-1W, McPherson County, Kansas as reflected by the files of Blackstone Drilling, Inc.

P. E. Plouffe
 P. E. Plouffe, President

Subscribed and sworn to before me a Notary Public in and for McPherson County, Kansas this 7th day of October, 1974.

Johnnie L. Schmidt
 Johnnie L. Schmidt - Notary Public

