

15-135-00008-00-00

STATE OF KANSAS
STATE CORPORATION COMMISSION


Give All Information Completely
Make Required Affidavit
Mail or Deliver Report to:
Conservation Division
State Corporation Commission
800 Bittling Building
Wichita, Kansas

WELL PLUGGING RECORD

Ness County, Sec. 18 Twp. 19 Rge. 21 (NW) W (W)

Location as "NE/CNW/SE/SW" or footage from lines NW NW NW
Lease Owner Kerr-McGee
Lease Name DeWald Well No. 1
Office Address Kerr-McGee Bldg., Okla. City, Oklahoma
Character of Well (completed as Oil, Gas or Dry Hole) Dry hole
Date well completed 8-9-55 19
Application for plugging filed 8-9-55 19
Application for plugging approved 8-9-55 19
Plugging commenced 10 p.m. 19
Plugging completed 10:30 p.m. 19
Reason for abandonment of well or producing formation Dry Hole

NORTH

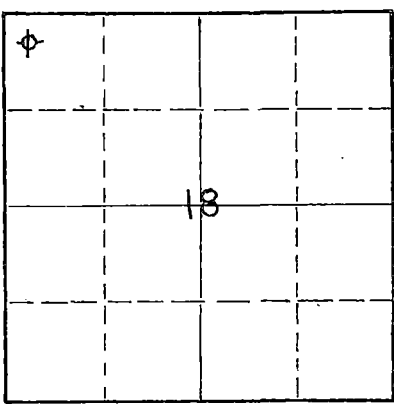

Locate well correctly on above Section Plat

If a producing well is abandoned, date of last production X 19
Was permission obtained from the Conservation Division or its agents before plugging was commenced? Yes

Name of Conservation Agent who supervised plugging of this well Horner
Producing formation _____ Depth to top _____ Bottom _____ Total Depth of Well 4760 Feet
Show depth and thickness of all water, oil and gas formations.

OIL, GAS OR WATER RECORDS

CASING RECORD

FORMATION	CONTENT	FROM	TO	SIZE	PUT IN	PULLED OUT
		0	330'	8 5/8		none

Describe in detail the manner in which the well was plugged, indicating where the mud fluid was placed and the method or methods used in introducing it into the hole. If cement or other plugs were used, state the character of same and depth placed, from _____ feet to _____ feet for each plug set.

Hole pumped full of heavy mud to 300'.
Hallibuton placed @ 300'. 1/3 sack of hulls placed on plug.
20 sacks common cement mixed through drill pipe placed on hulls and plug.
Heavy mud pumped to 35'.
Halliburton plug placed @ 35'. 1/3 sack of hulls on plug.
10 sacks of cement mixed and placed on plug, to base of cellar.
Rat hole plugged with 5 sacks cement.

(If additional description is necessary, use BACK of this sheet)

Name of Plugging Contractor Badger Drillers Inc.
Address Box 289, Tulsa, Oklahoma

STATE OF Oklahoma, COUNTY OF Tulsa, ss.
Don E. Burkitt (employee of owner) or (owner or operator) of the above-described well, being first duly sworn on oath, says: That I have knowledge of the facts, statements, and matters herein contained and the log of the above-described well as filed and that the same are true and correct. So help me God.

(Signature) [Signature]
Box 287, Tulsa, Oklahoma (Address)

SUBSCRIBED AND SWORN TO before me this 18th day of August, 19 55

My commission expires 4-13-58

Julia [Signature] Notary Public.
STATE CORPORATION COMMISSION
AUG 26 1955
CONSERVATION DIVISION
Wichita, Kan.

PLUGGING
FILE SEC 18 T19 R21W
BOOK PAGE 15 LINE 13

Kerr - McGee
 DeWald #1
 NW-NW-NW-Sec. 18-19S-21W
 Ness County, Kansas

Drillers Log

Drilling Started 7-23-55
 Drilling Ended 8-9-55
 8 5/8" Casing Set At 330'

<u>FROM</u>	<u>TO</u>	<u>FORMATION</u>	<u>REMARKS</u>
0	40	Clay-Sand	
40	330	Shale & Shells	Ran 333' of 8 5/8" Casing Set
330	440	Sand	At 330' with 225 sacks.
440	625	Shale & Shells	
625	850	Red Bed	
850	1100	Sand	
1100	1500	Shale & Shells	
1500	1875	Shale	
1875	2300	Shale & Shells	
2300	2650	Lime	
2650	3065	Lime-Shale	
3065	3180	Shale	
3180	3614	Shale-Lime	
3614	4250	Lime	
4250	4376	Lime-Chert	
4376	4429	Chert & Lime	
4429	4468	Lime - Chert	
4468	4513	Lime	
4513	4559	Lime & Chert	
4559	4760	Lime	Total Depth - Dry Hole

This is a certified copy of the Drillers Log as shown by the Daily Drilling Reports.

[Signature]
 Badger Drillers, Inc.

Subscribed and sworn to before me this 23rd day of August, 1955.

Margery Walsh
 Notary Public

My Commission expires 7-6-59

PLUGGING
 FILE SEC 18 19 R 21W
 BOOK PAGE 145 LINE 13

RECEIVED
 STATE CORPORATION COMMISSION
 AUG 26 1955
 CONSERVATION DIVISION
 Wichita, Kansas