

STATE OF KANSAS  
STATE CORPORATION COMMISSION

Give All Information Completely  
Make Required Affidavit  
Mail or Deliver Report to:  
Conservation Division  
State Corporation Commission  
211 No. Broadway  
Wichita, Kansas

WELL PLUGGING RECORD

Ness County. Sec. 8 Twp. 19S Rge. 21W (E) (W)

Location as "NE/CNW/SW" or footage from lines C NE SW

Lease Owner Alpine Oil & Royalty Co., Inc.

Lease Name Emma Stieben Well No. 1

Office Address 800 Bitting Building, Wichita, Kansas 67202

Character of Well (completed as Oil, Gas or Dry Hole) Dry hole

Date well completed October 12, 1968 19

Application for plugging filed October 12, 1968 (by phone) 19

Application for plugging approved October 12, 1968 (by phone) 19


Plugging commenced October 12, 1968 19

Plugging completed October 12, 1968 19

Reason for abandonment of well or producing formation Nonproductive in commercial quantities

If a producing well is abandoned, date of last production \_\_\_\_\_ 19

Was permission obtained from the Conservation Division or its agents before plugging was commenced? Yes

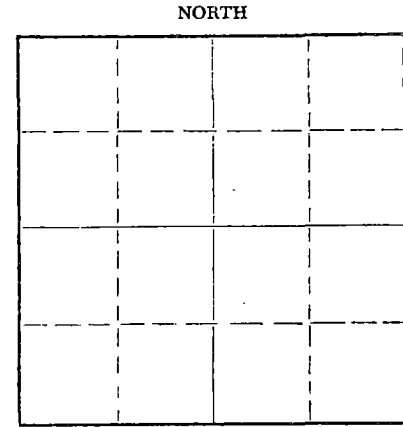

Locate well correctly on above Section Plat

Name of Conservation Agent who supervised plugging of this well Leo Massey

Producing formation \_\_\_\_\_ Depth to top \_\_\_\_\_ Bottom \_\_\_\_\_ Total Depth of Well 4400 Feet

Show depth and thickness of all water, oil and gas formations.

OIL, GAS OR WATER RECORDS

CASING RECORD

FORMATION	CONTENT	FROM	TO	SIZE	PUT IN	PULLED OUT
				8 5/8"	323'	cemented

Describe in detail the manner in which the well was plugged, indicating where the mud fluid was placed and the method or methods used in introducing it into the hole. If cement or other plugs were used, state the character of same and depth placed, from \_\_\_\_\_ feet to \_\_\_\_\_ feet for each plug set.

Heavy mud from total depth to 660 feet. Plug and 70 sacks cement at 660 feet. Second plug at 300 feet and 20 sacks cement; third plug at 40 feet and 1/2 sacks hulls and 10 sacks cement to bottom of cellar.

RECEIVED  
STATE CORPORATION COMMISSION  
OCT 17 1968  
CONSERVATION DIVISION  
Wichita, Kansas

(If additional description is necessary, use BACK of this sheet)

Name of Plugging Contractor Gabbert-Jones, Inc.

Address 830 Sutton Place, Wichita, Kansas 67202

STATE OF Kansas, COUNTY OF Sedgwick, ss.


Dwight J. Wilson (employee of owner) or (owner or operator) of the above-described well, being first duly sworn on oath, says: That I have knowledge of the facts, statements, and matters herein contained and the log of the above-described well as filed and that the same are true and correct. So help me God.

(Signature) Dwight J. Wilson  
800 Bitting Bldg., Wichita, Kansas 67202  
(Address)

SUBSCRIBED AND SWORN to before me this 16th day of October, 19 68

My commission expires December 10, 1968

Evelyn Wanko  
Evelyn Wanko  
Notary Public.

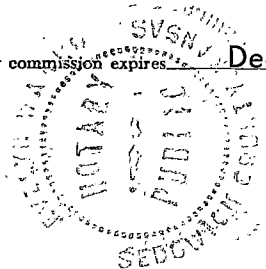

GABBERT-JONES, INC.  
WICHITA, KANSAS  
DRILLERS' WELL LOG

STIEBEN #1  
 C NE SW Section 8-19S-21W  
 Ness County, Kansas

Commenced: October 3, 1968  
 Completed: October 12, 1968

OPERATOR - Alpine Oil & Royalty Co., Inc.

DEPTH		FORMATION	REMARKS
From	To		
0	35	Surface clay	
35	45	Post rocks	
45	250	Shale	
250	280	Sand	
280	323	Blue shale and shells	Ran 8 joints of 8-5/8" casing, set @ 323' w/175 sacks cement.
323	390	Shale	
390	865	Shale and shells	
865	1135	Sand	
1135	1185	Shale	
1185	1440	Red bed and shale	
1440	1472	Anhydrite	
1472	2020	Shale and shells	
2020	2270	Shale	
2270	2325	Lime and shale streaks	
2325	2600	Shale and lime	
2600	2675	Lime	
2675	2700	Lime and shale streaks	
2700	3815	Shale and lime	
3815	3878	Lime	
3878	3950	Lime and shale	
3950	4242	Lime	
4242	4311	Conglomerate and lime	
4311	4314	Chert	
4314	4382	Lime and chert	
4382	TD		Dry and abandoned.

I, E. E. HALL, certify this is a correct copy of the Drillers' Log for the well drilled in the C NE SW Section 8-19S-21W, Ness County, Kansas, to the best of my knowledge and belief.

*E. E. Hall*

E. E. HALL

STATE OF KANSAS )  
 ) SS  
 COUNTY OF SEDGWICK )

Before me, the undersigned, a Notary Public within and for said County and State, on this 15th day of October, 1968, personally appeared E. E. Hall to me personally known to be the identical person who executed the within and foregoing instrument and acknowledged to me that he executed the same as his free and voluntary act and deed for the uses and purposes therein set forth.

IN WITNESS WHEREOF, I have hereunto set my hand and official seal the day and year last above written.

My Commission Expires Feb. 1, 1972

*Barbara J. Layton*  
 Barbara J. Layton, Notary Public

